

18 4281
50975

SEC. 15
DECLAND
SEC. 10

SEC. 10
O'CLAND
SEC. 9

Block K
Block L
Block M
Block N
Block O
Block P
Block Q
Block R
Block S
Block T
Block U
Block V

of the Woods
Application No. 58616


POINT OF DIVERSION- 1316' S + 1663' E OF THE
NWCORNER OF SEC 15, T.37S, R.5E, W.4.
POINT OF USE: LOTS, BLOCK L, LAKE OF THE
WOODS SUMMER HOME TRACT.

RECEIVED
JUL 24 1979
WATER RESOURCES DEPT
SALEM, OREGON

LAKE OF THE WOODS

Application No. 58616
Permit No. 44281

RECEIVED
MAY 03 1979
WATER RESOURCES DEPT
SALEM, OREGON

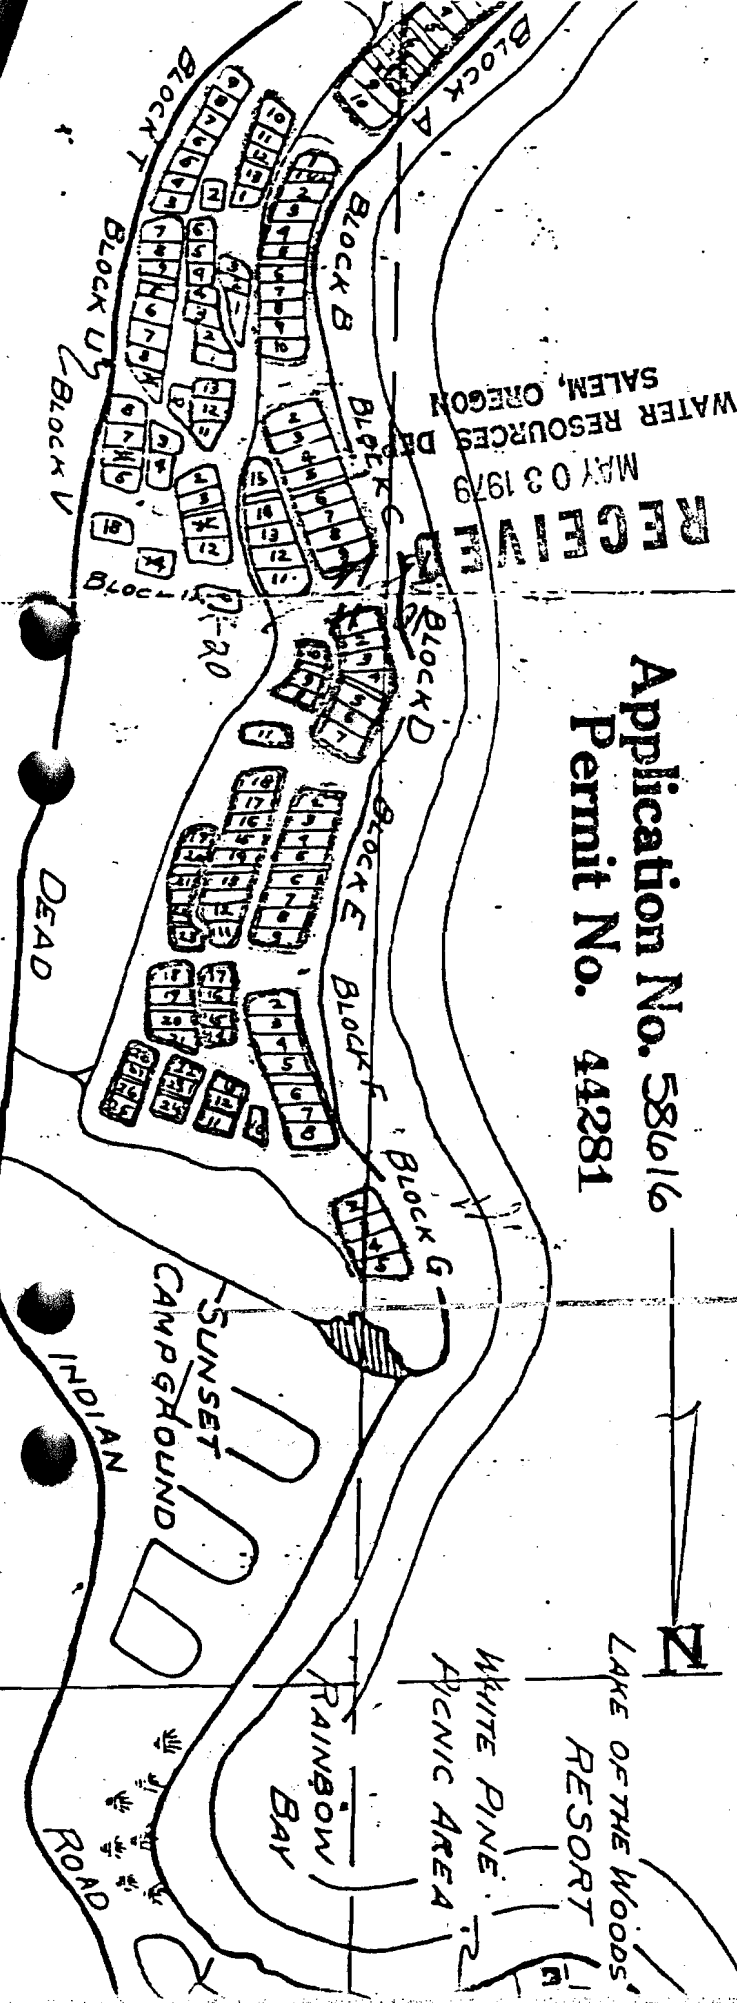

new for removal