




T. 6 S., R. 10 W., W.M.

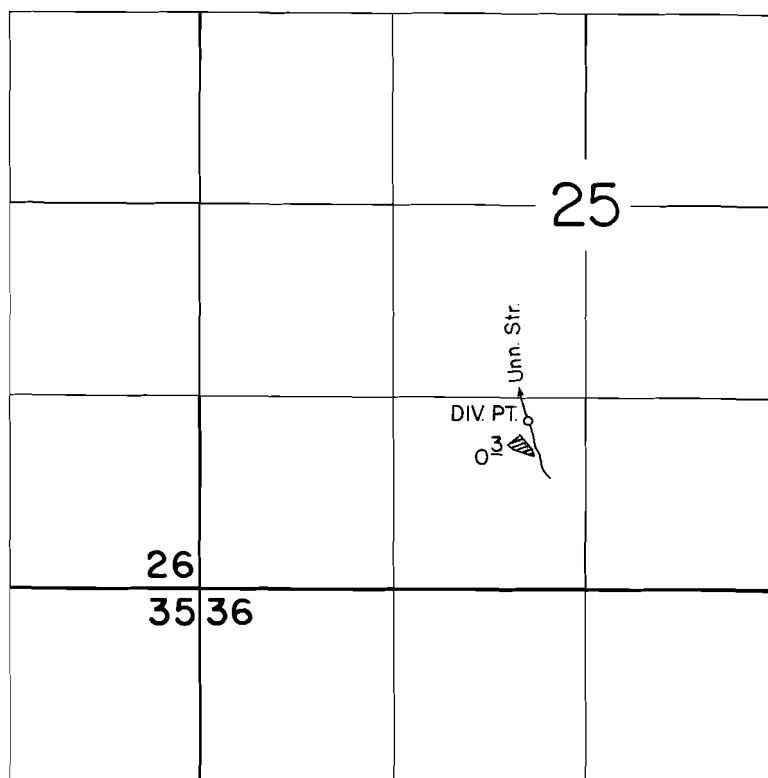

DIV. PT. LOC: 1480'S. & 930'E. FROM NE. CORNER NW 1/4 SW 1/4 SEC. 25

SCALE: 1" = 1320'

FINAL PROOF SURVEY UNDER

Application No. 58758... Permit No. 44340...
IN NAME OF

ANDREE L. CUENOD &/OR MAURINE S. LEONARD

Surveyed AUG. 4... 1986, by T. WARREN.....