


T.5S., R.5W., W.M.

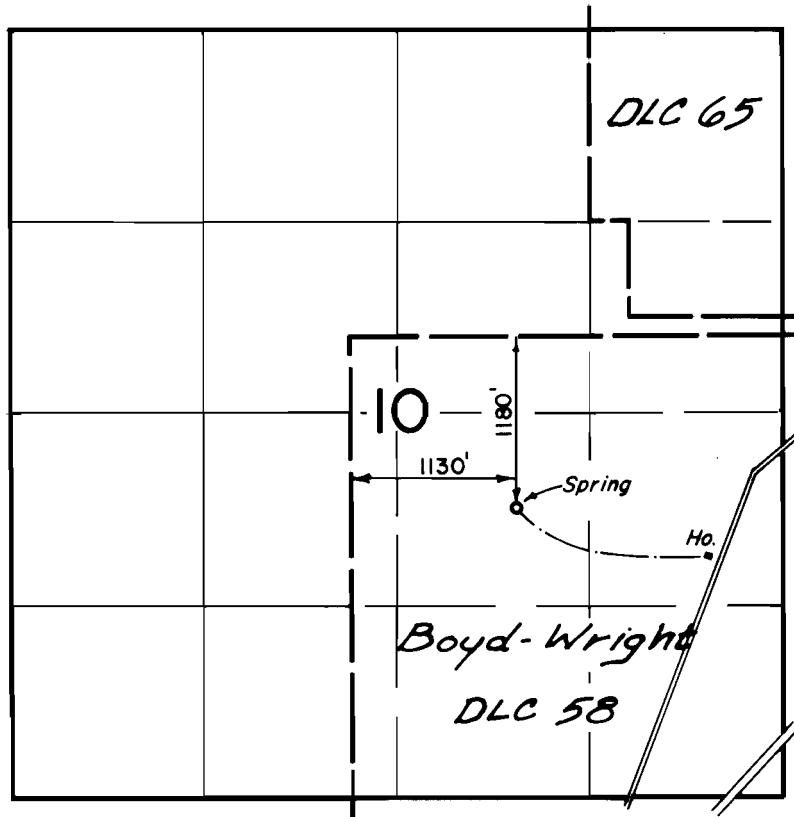

FINAL PROOF SURVEY
UNDER

Application No. 59441 Permit No. 44524

IN NAME OF

Michael Lee Buseman

Surveyed June 6 1980, by J. C. Brown