


T. 37S., R. 14 W., W.M.

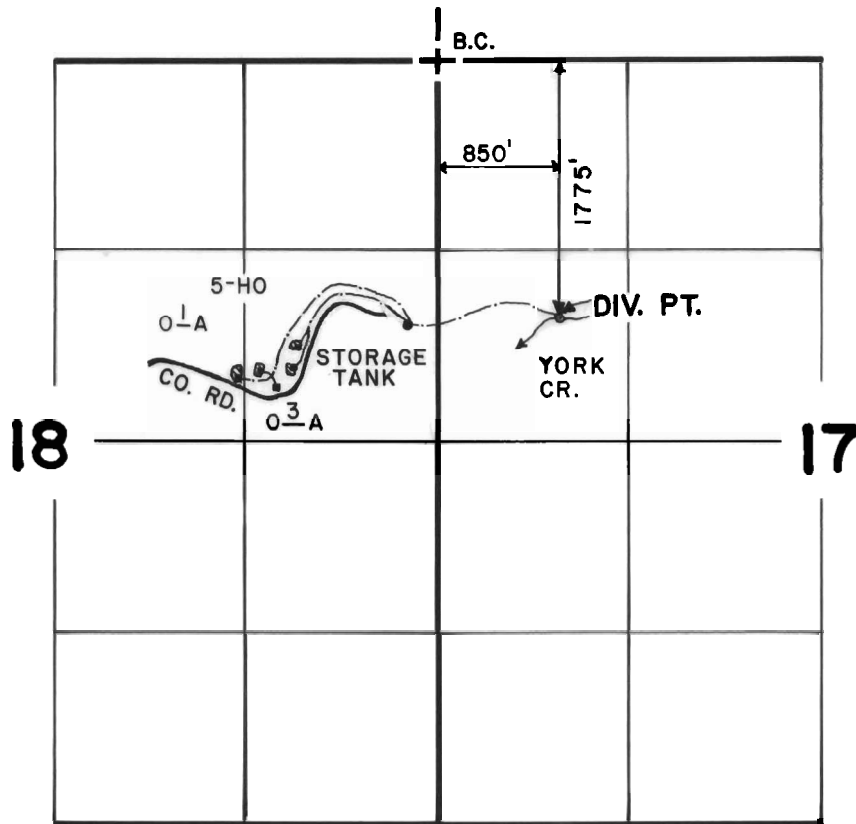

SCALE: 4" = 1 MILE

FINAL PROOF SURVEY
UNDER

Application No. **60715** Permit No. **45477**
IN NAME OF

JAMES A. CHRISTENSEN

Surveyed **SEPT. 24 1985**, by **J.M. SCHMORDE**