




T. 2 S., R. 3 E., W.M.

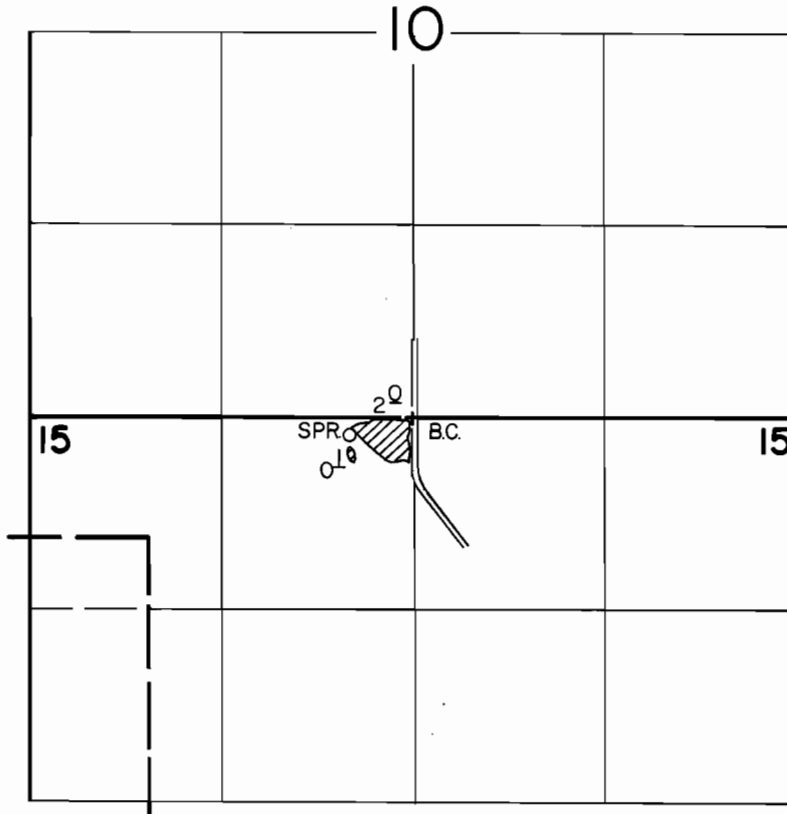

DIV. PT. LOC: 120' S. & 440' W. FROM N. 1/4 CORNER SECTION 15

SCALE: 1" = 1320'

FINAL PROOF SURVEY
UNDER

Application No. 65104... Permit No. 47576...
IN NAME OF

MRS. HELYN SHORES (DEEP CREEK NURSERY)

Surveyed SEPT. 5, 1986, by T. WARREN