


T. 11 S., R. 4 W., W.M.

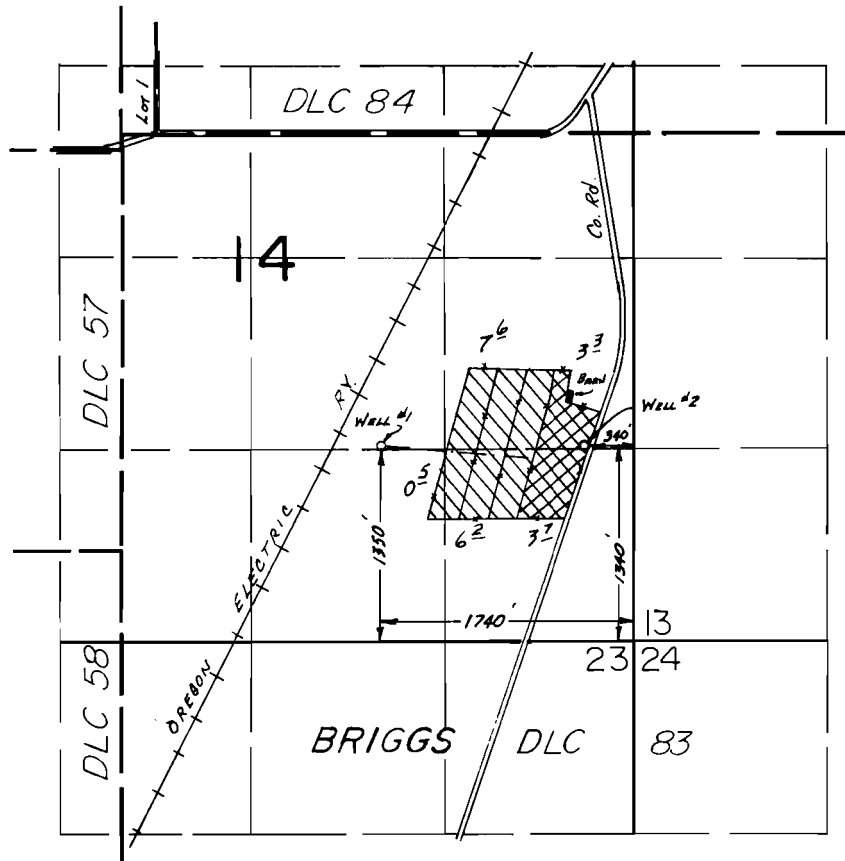

FINAL PROOF SURVEY UNDER

Application No. G-6834. Permit No. G-6328....
IN NAME OF

.....JACK & BESSIE KALINA.....

Surveyed MAY 2.... 1980, by S.C. BROWN.....