


T.18&2S., R.4&5E., W.M.

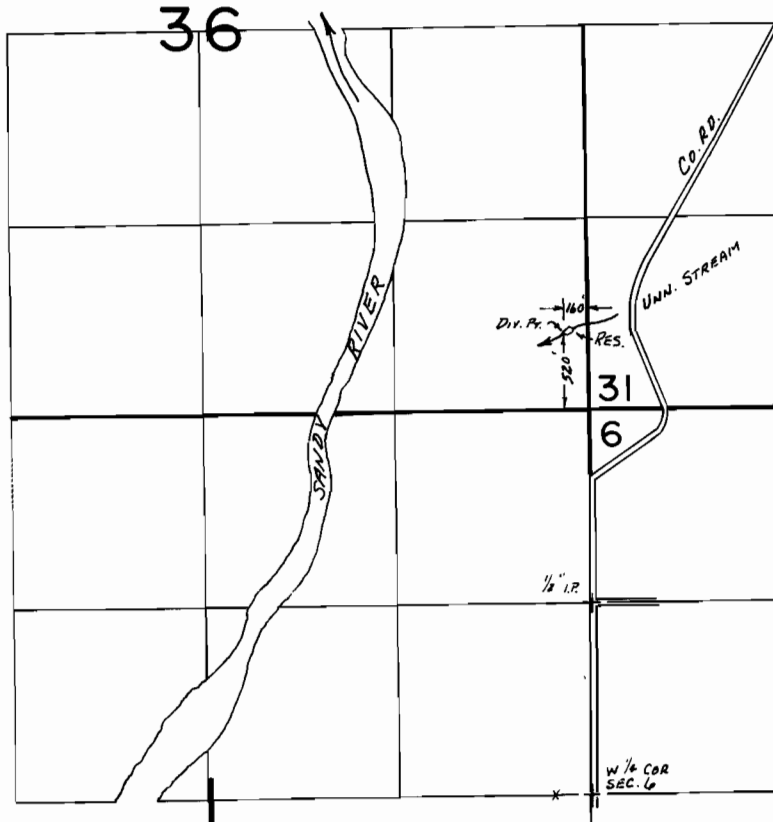

FINAL PROOF SURVEY

UNDER

R-53294 R-6328
Application No. 53295 Permit No. 39545.....
IN NAME OF

.....WILLYS M. SILLS.....

Surveyed MAY 10... 19.79., by R.G. MUCKEN.....