


T.5S., R1E., W.M.

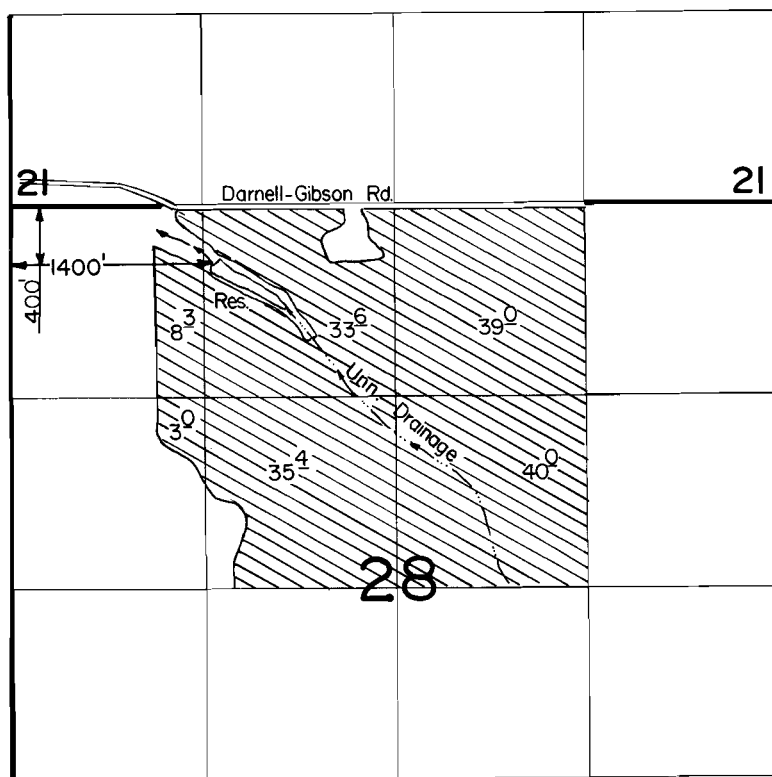

Scale: 1" = 1320'

FINAL PROOF SURVEY

UNDER

R-59942 R-8216
Application No. 59943... Permit No. 45427.....
IN NAME OF

MICHAEL GASSNER

Surveyed JULY....11... 1985., by J.T...WARREN.....