


T.5S., R.1E., W.M.

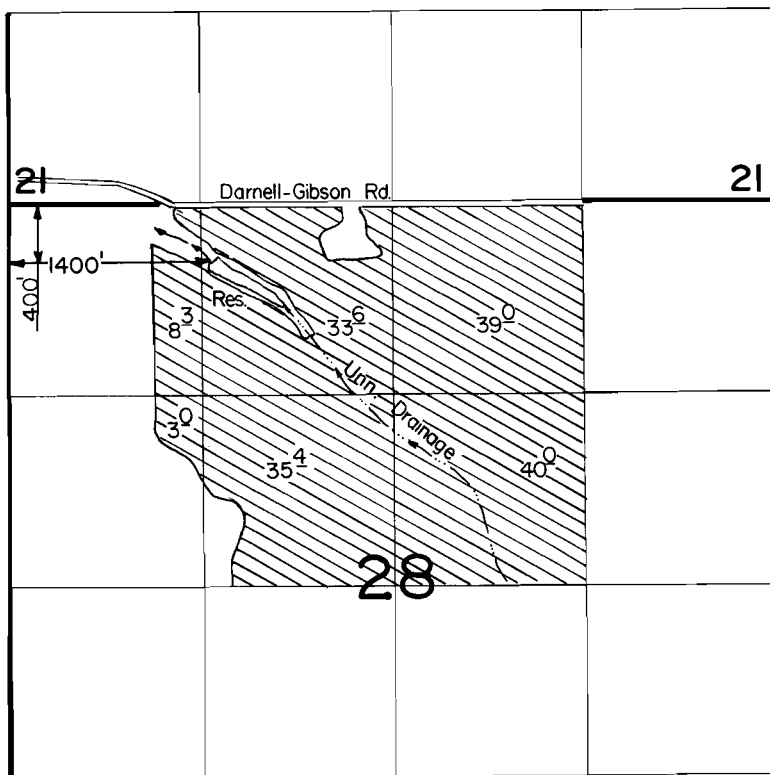

Scale: 1" = 1320'

**FINAL PROOF SURVEY**  
UNDER

R-59942

R-8216

Application No. 59943... Permit No. 45427.....

IN NAME OF

**MICHAEL GASSNER**

Surveyed JULY...11... 1985., by J.T. WARREN.....