


T.17S., R.11E., W.M.

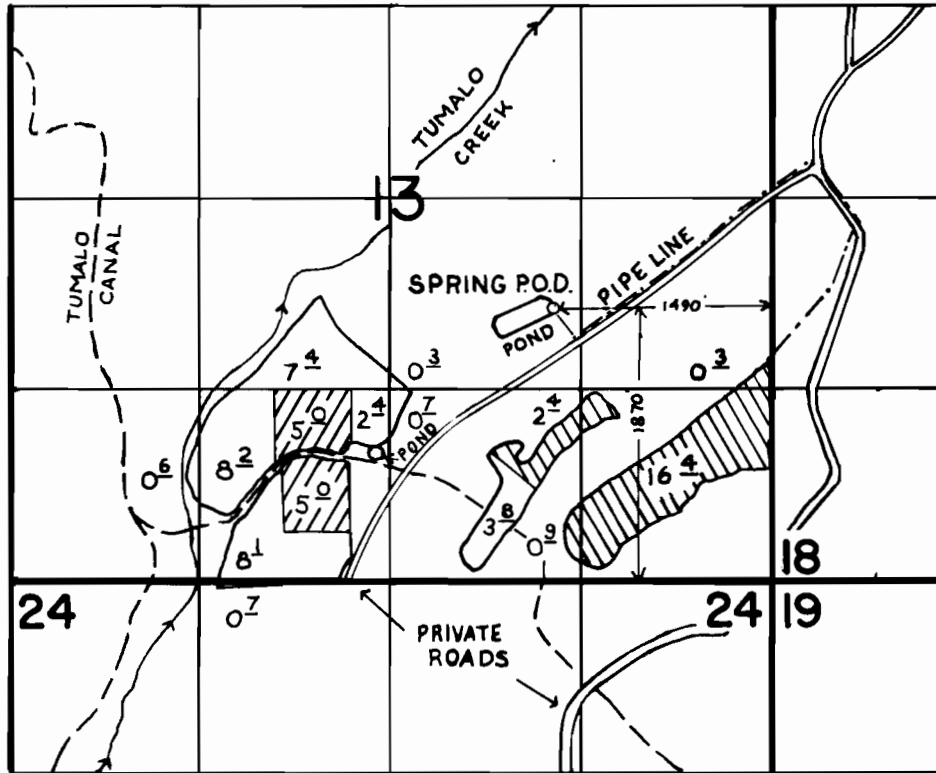

SCALE: 1" = 1320'

FINAL PROOF SURVEY

UNDER

PART OF TRANSFER NO. 2559 

and

Application No. 49006.. Permit No. 36686..... 

IN NAME OF

ROBERT COATS

Surveyed JULY 8..... 1985., by LESLIE OLSON....