


T. 30 S., R. 3 W., W.M.

SCALE: 4" = 1 mile

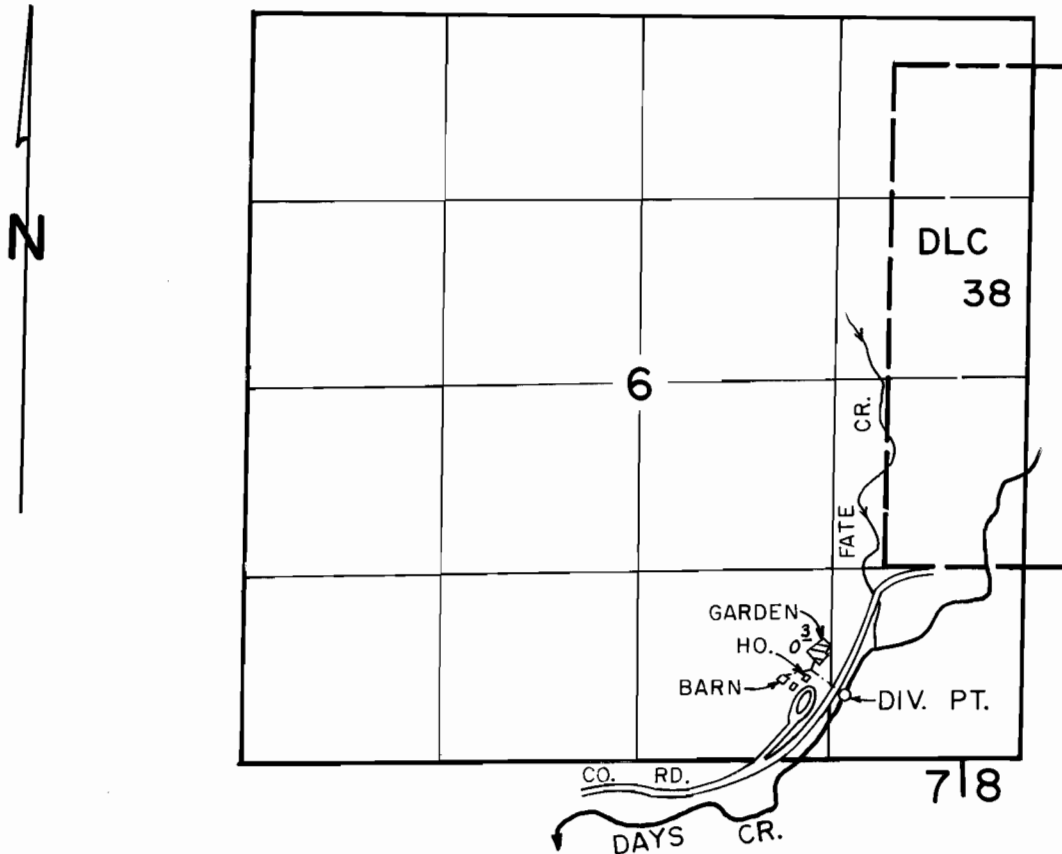

DIV. PT. LOCATED 880' S. and 260' W. of SW CORNER DLC 38

FINAL PROOF SURVEY
UNDER

Application No. 50378.. Permit No. 38026.....
IN NAME OF

LUTHER, BETTY, ROBERT & SANDRA CLARK

Surveyed AUG. 25, 1983, by J. S. DONALDSON