


T. 19 S., R. 12 W., WM.

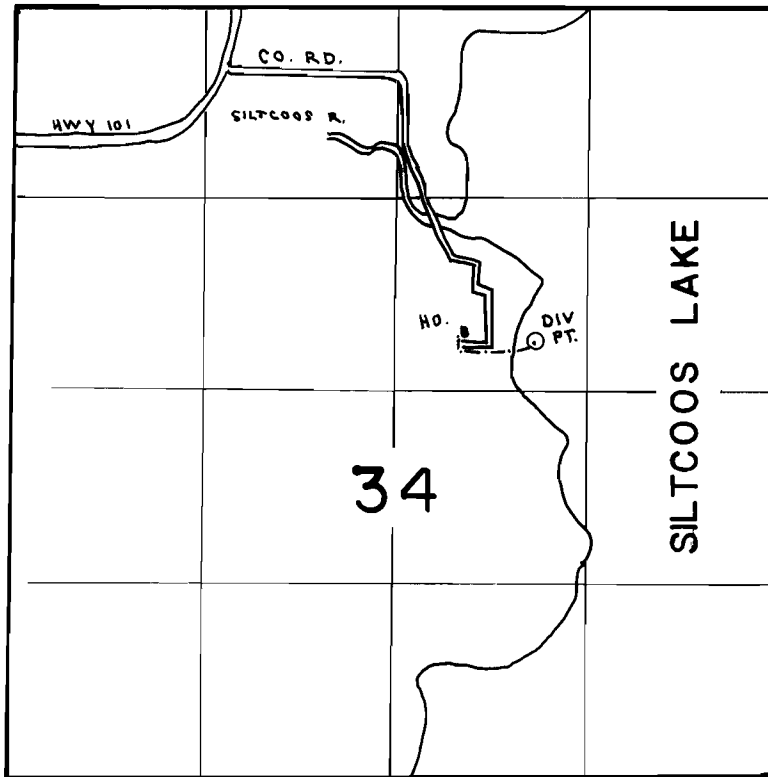

DIV. PT. LOC: 2300' S. & 3600' E. OF NW. COR. SEC. 34

FINAL PROOF SURVEY
UNDER

Application No. 64737. Permit No. 47477.....
IN NAME OF

WILLIAM DAVID LANE

Surveyed NOV. 4, 1983, by P. PAGTER.....