


T.26S.,R.8W.,W.M.

Section I

SW 1/4 SE 1/4

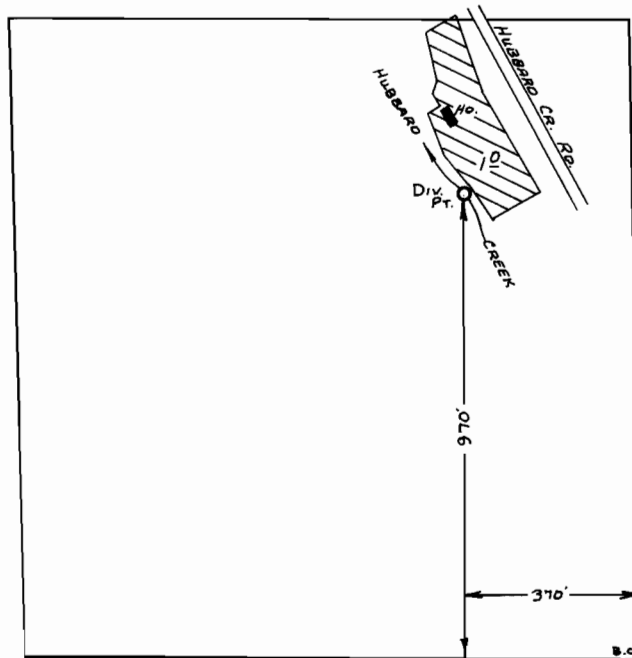

SCALE : 1" = 400'

FINAL PROOF SURVEY
UNDER

Application No. 50451.. Permit No. 38105.....
IN NAME OF

JOE J. & CORDELIA B. JAMES.....

Surveyed May 11.. 1982., by L. M. TOLL.....