


T.7N.R.88&9W.W.M.

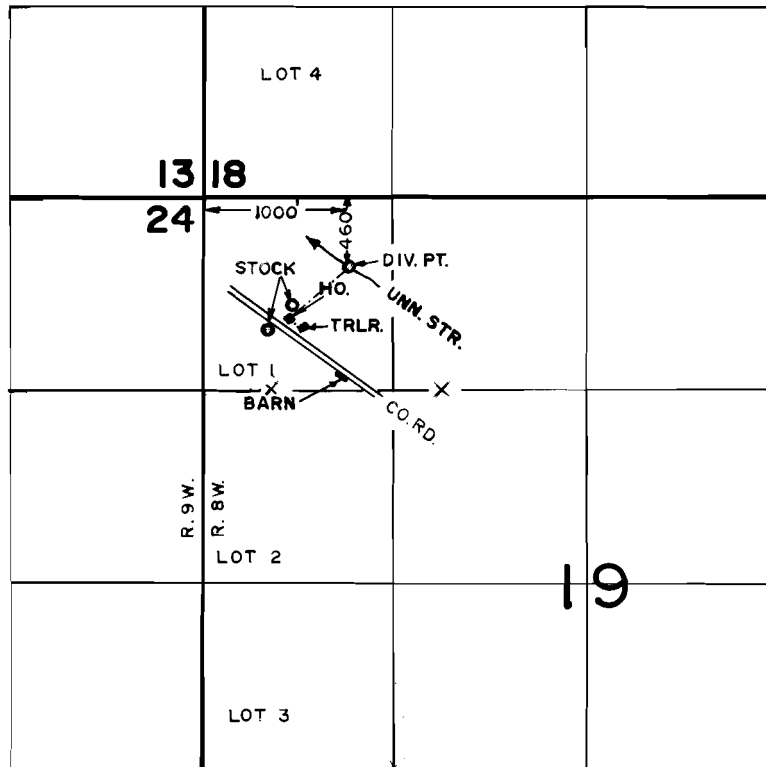

FINAL PROOF SURVEY
UNDER

Application No. 50498 Permit No. 38132.....
IN NAME OF

MARVIN A & ANN L FAUSETT.....

Surveyed FEB. 22. 1980. by R.G. MUCKEN.....