


T. 38 S., R. 4 W., W. M.

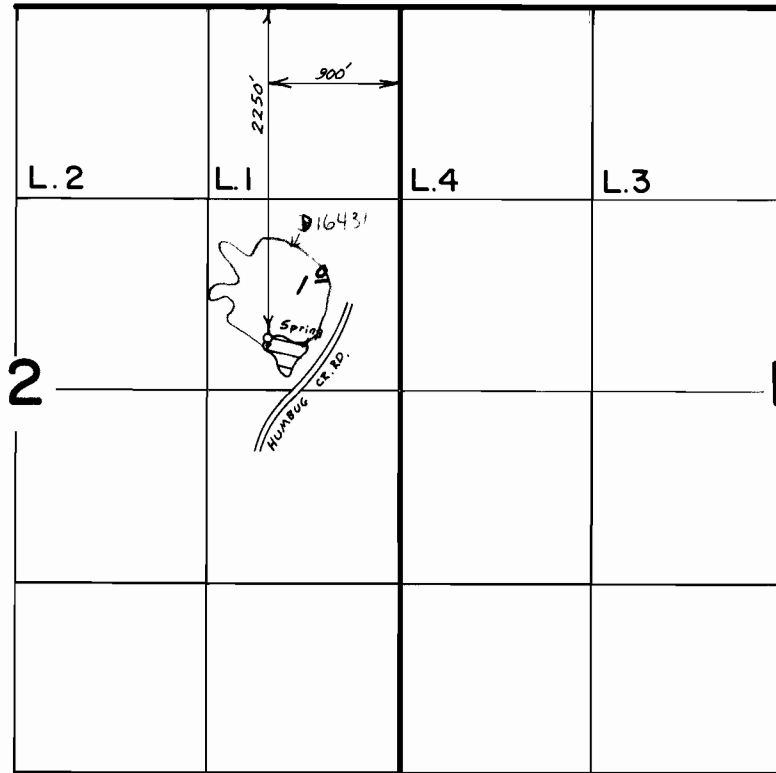

Scale 1"=1320'

FINAL PROOF SURVEY UNDER

Application No. 50501... Permit No. 38134
IN NAME OF

..... JOYCE J. PEEK

Surveyed July 7, 1986, by B.S. JAMES.....