


T. 38 S., R. 7 W., W. M.

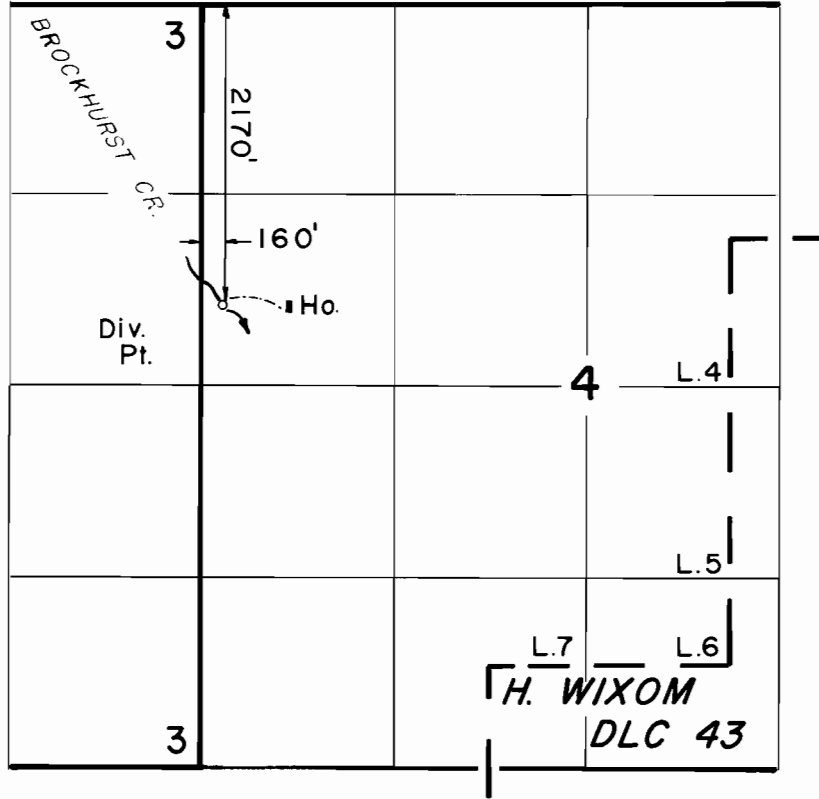

Scale: 1" = 1320'

FINAL PROOF SURVEY UNDER

Application No. 50514 Permit No. 38144
IN NAME OF

JOHN WASHBURN

Surveyed JUL. 17. 1986. by B. S. JAMES.