


T.25 S., R.7 W., W.M.

SECTION 8

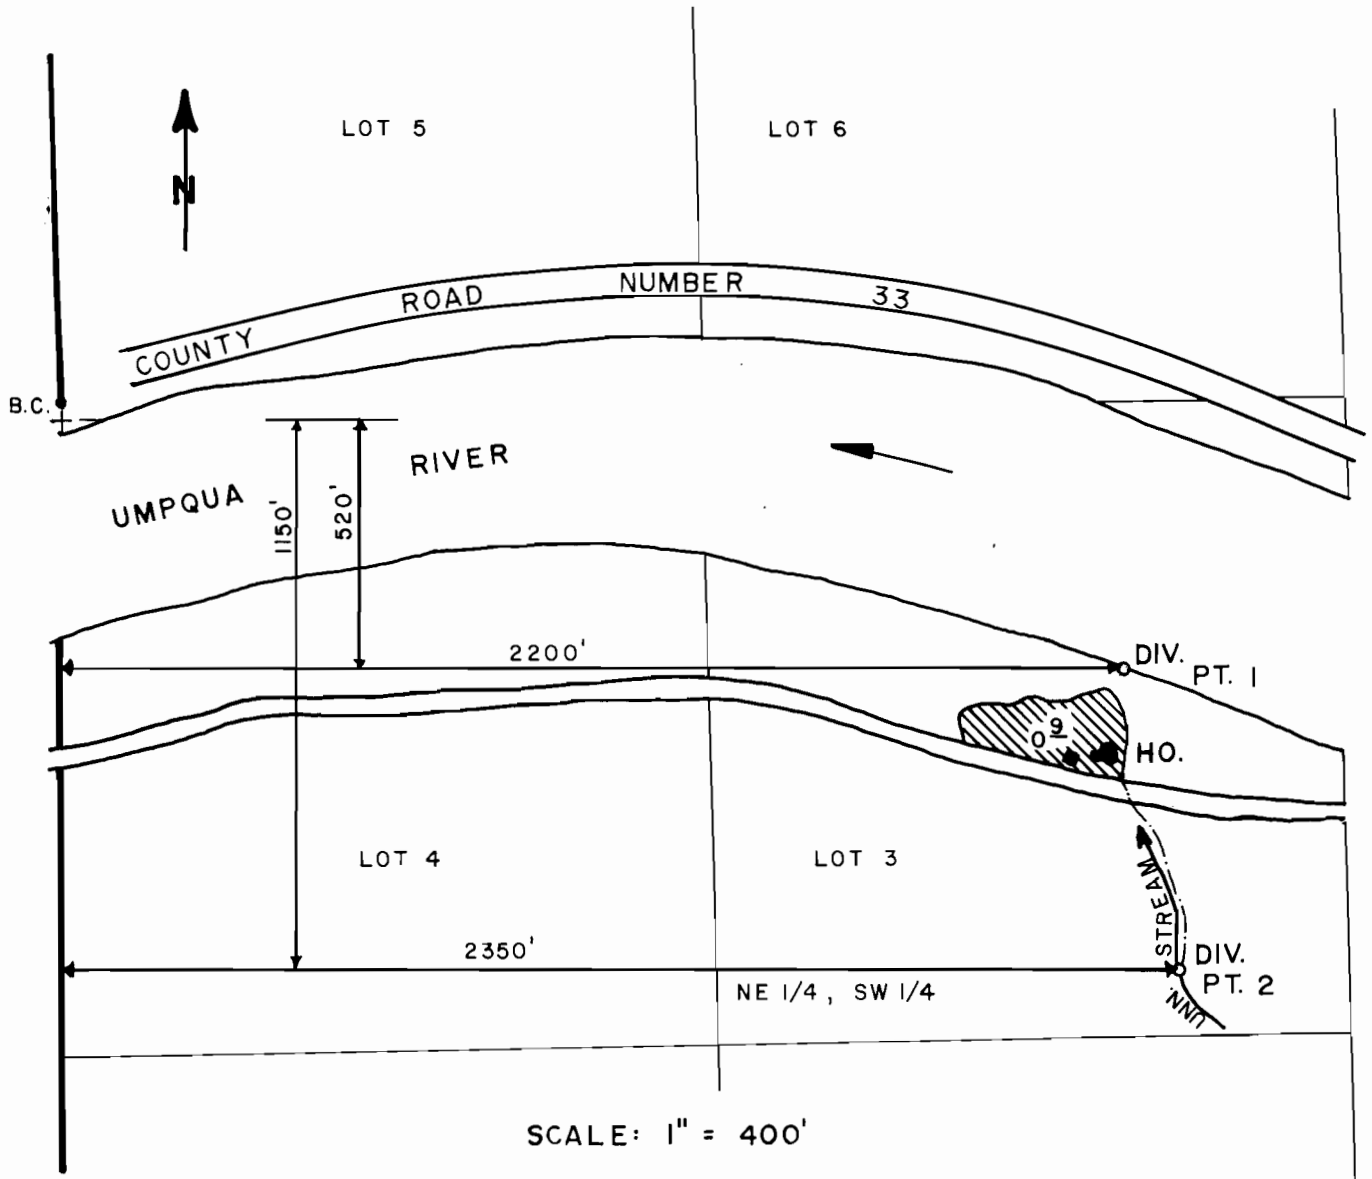

FINAL PROOF SURVEY UNDER

Application No. 50531 Permit No. 38155
IN NAME OF

ROBERT H. EBERLEIN

Surveyed AUG. 11, 1986, by J. M. SCHMORDE