


T. 38 S., R. 7 W., W. M.

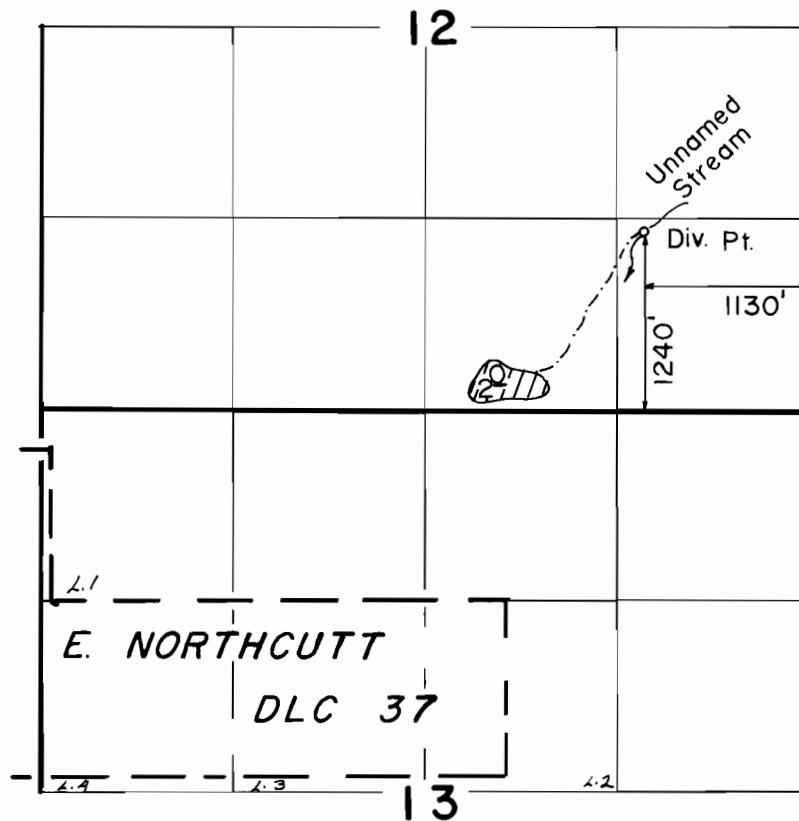

Scale: 1" = 1320'

FINAL PROOF SURVEY
UNDER

Application No. 53300 Permit No. 38209
IN NAME OF

CHARLIE VALDEZ

Surveyed JUL. 24. 1986, by B. S. JAMES.