



T.I.O.S., R.6E., W.M.

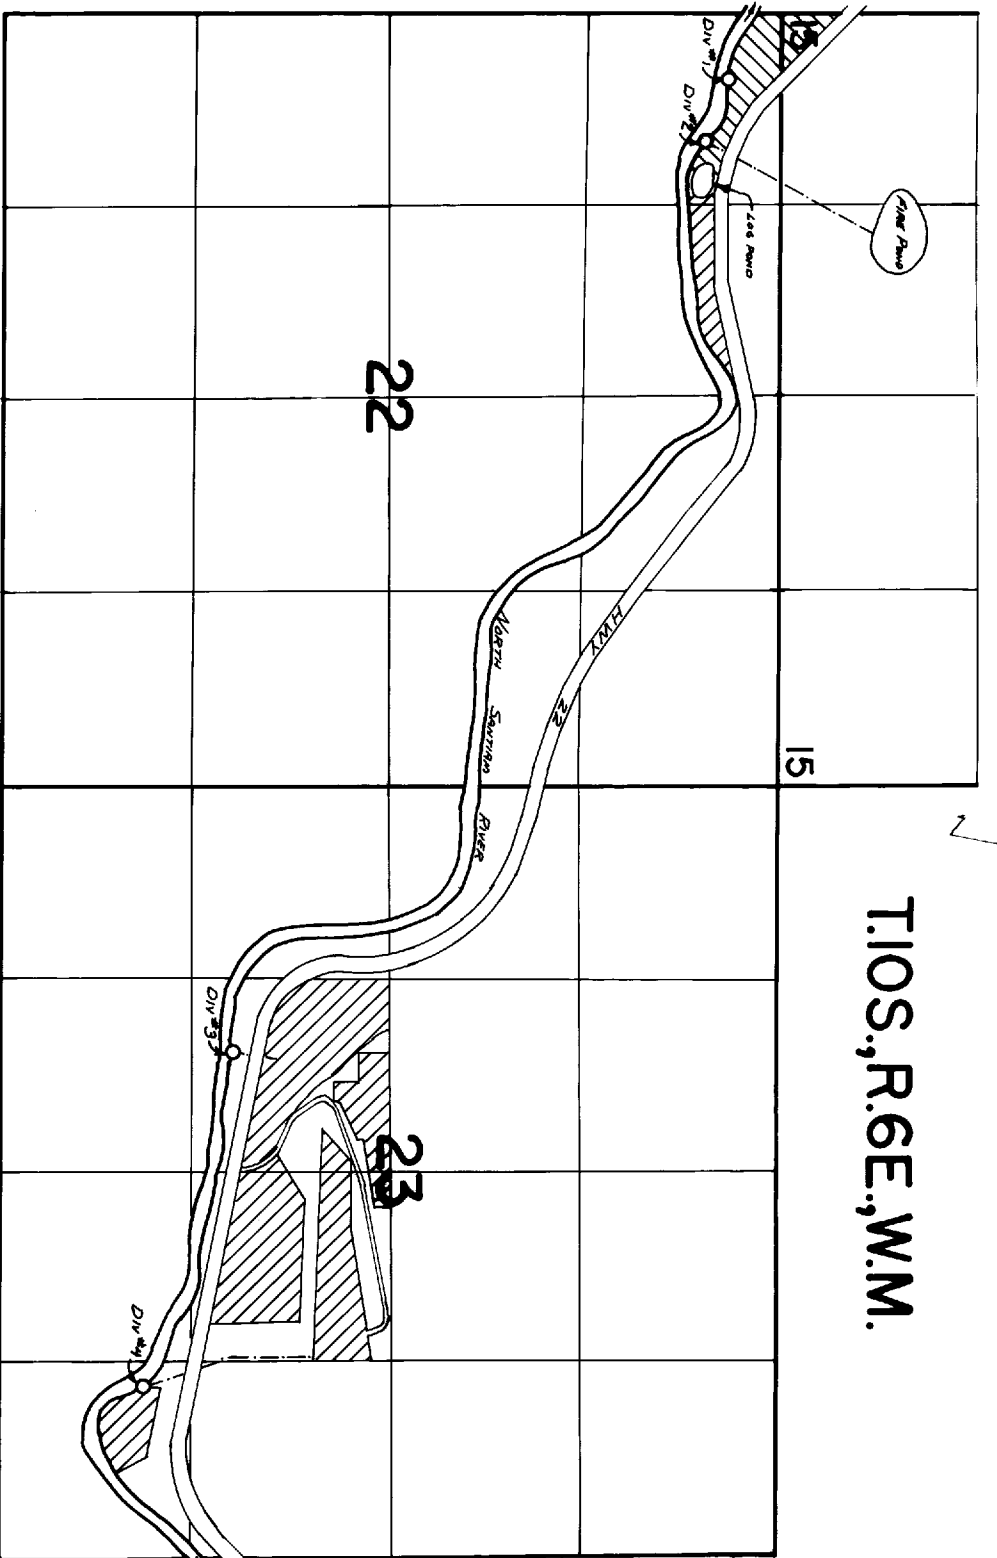

DIVERSION LOCATION: #1-350 Ft. S and 450 Ft. E. } Both from NW Cor. Sec. 22
#2-500 Ft. S and 860 Ft. E. }

#3-1060 Ft. S and 1820 Ft. E. } Both from W 1/4 Cor. Sec. 23
#4-1700 Ft. S. and 4100 Ft. E. }

FINAL PROOF SURVEY UNDER

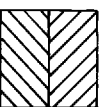

Log Deck Sprinkling
FINE PROTECTION

Application No. 50748. Permit No. 38328.
IN NAME OF

GREEN VENEER, INC.

Surveyed July 28, 1981 by S. C. BROWN