


T. 37 S., R. 5 W., W.M.  
Sec. 30

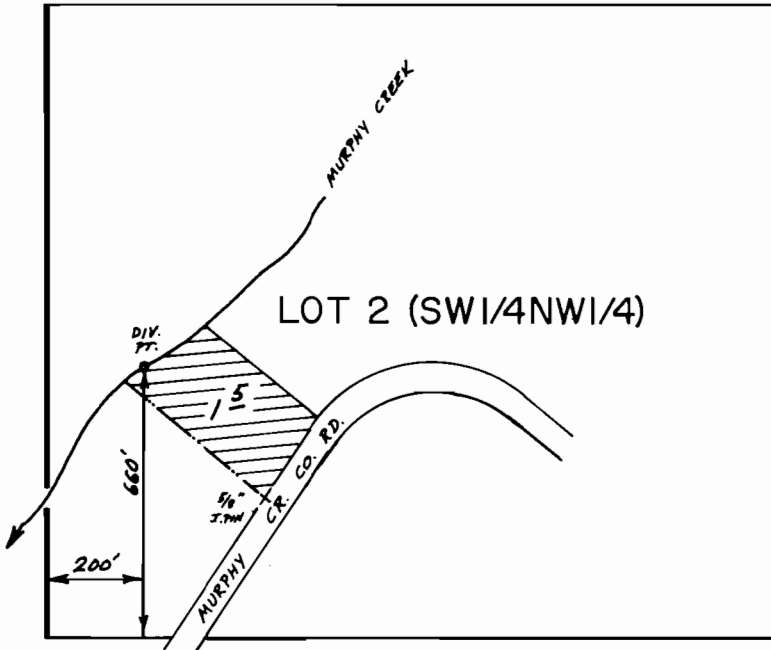

Scale 1" = 400'

**FINAL PROOF SURVEY**  
UNDER

Application No. 50858.. Permit No. 38399.....  
IN NAME OF

.....BRUCE L. HIRSHMAN.....

Surveyed Sept. 28, 1983., by B.S. JAMES.....