


T.14S., R.9 & 10W., W.M.

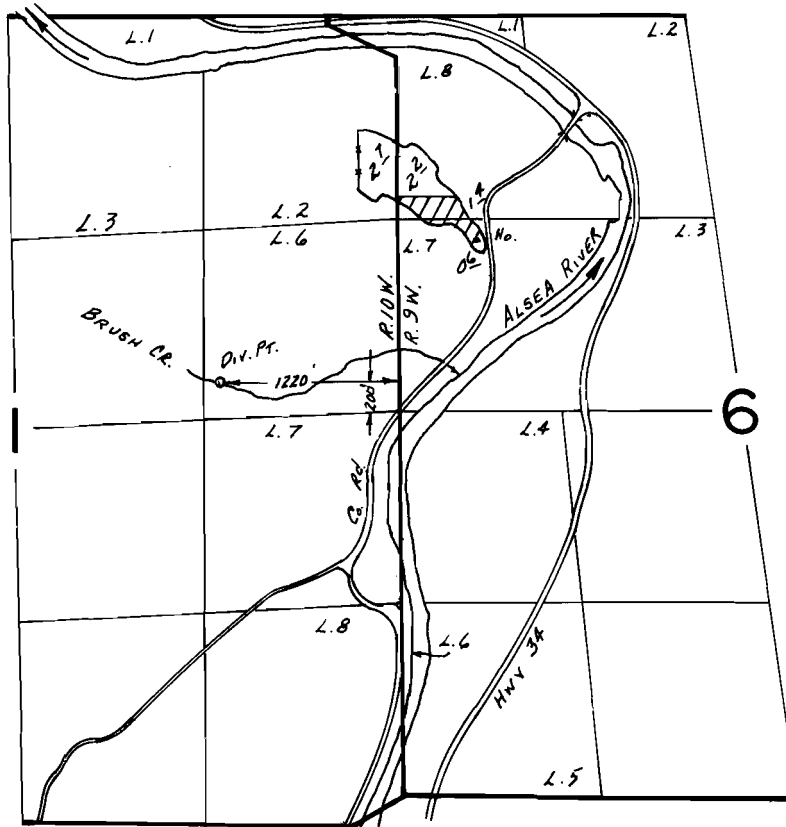

FINAL PROOF SURVEY
UNDER

Application No. 53462... Permit No. 38415...
IN NAME OF

.....WAYNE L. & JUDITH A. NIEHAUS

Surveyed SEPT. 28 1979, by S. C. BROWN.....