


T. 26 S., R. 6 W., W.M.  
SEC. 28 & 33

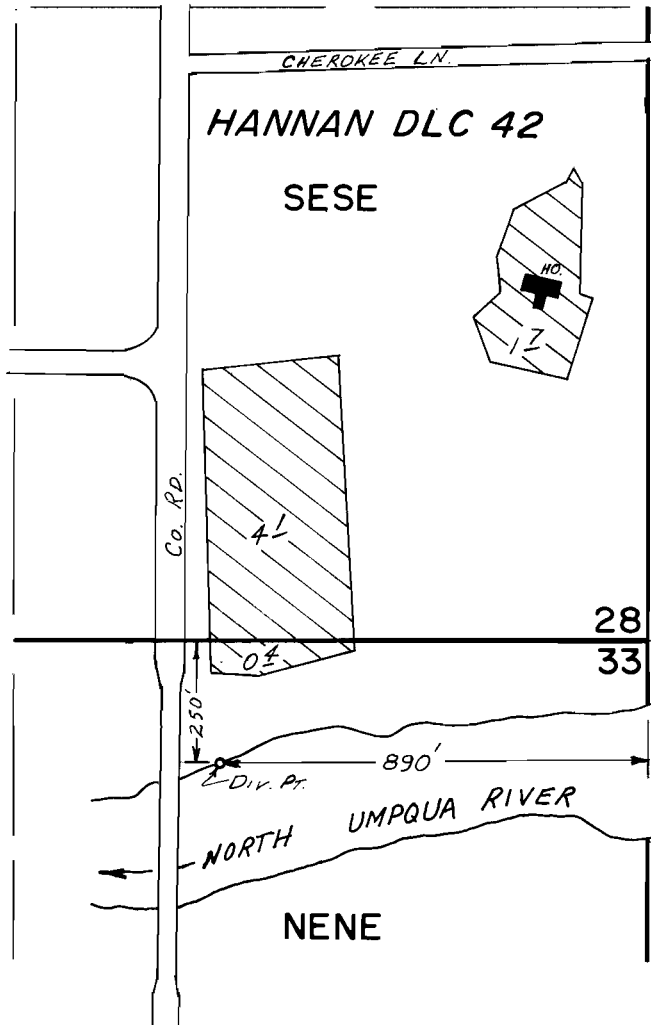

**FINAL PROOF SURVEY**  
UNDER

Application No. 50952... Permit No. 38464.....  
IN NAME OF

.....**ALLYN C. FORD**.....

Surveyed ..AUG. 11... 1982., by L.M. TOLL.....