


T. 37 S., R. 8 W., W.M.

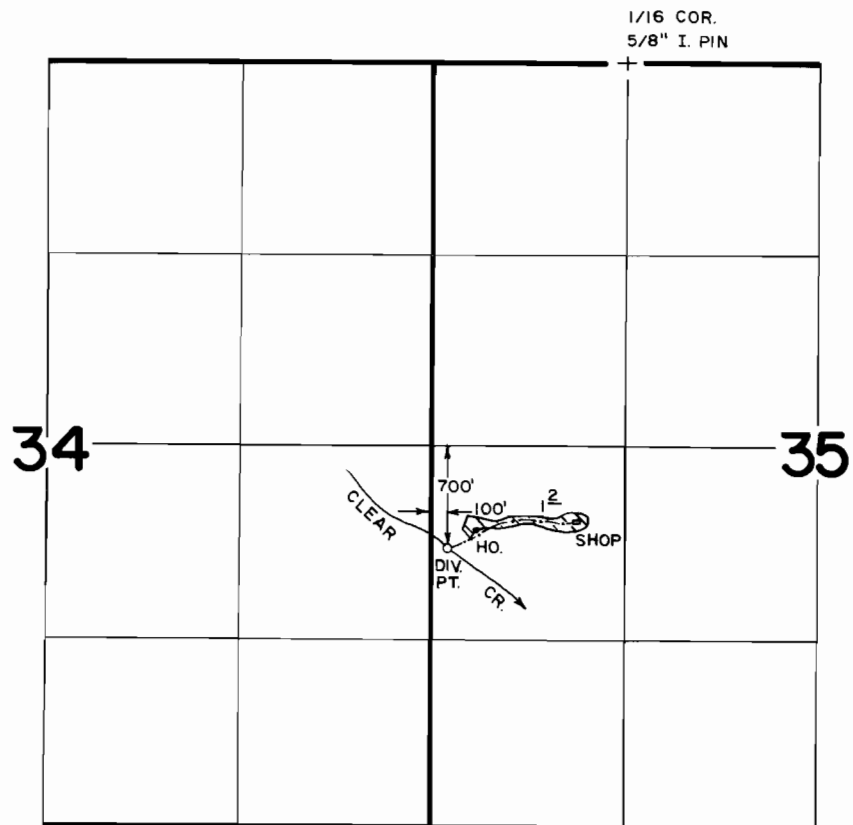

FINAL PROOF SURVEY
UNDER

Application No. 50998 Permit No. 38493
IN NAME OF

JONAS LOHR

Surveyed OCT. 26 1983, by B. S. JAMES

Scale: 4" = 1 Mile