


# T.4S. R.4W. W.M.

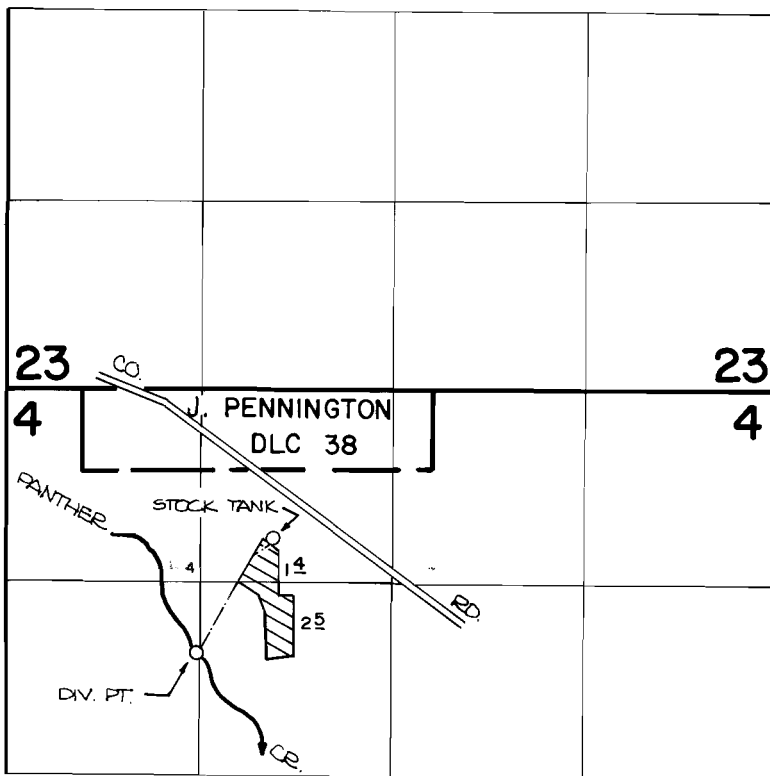

DIVERSION POINT IS LOCATED 1275' S. AND 760' E. FROM THE S.W. CORNER OF THE J. PENNINGTON DLC # 38.

## FINAL PROOF SURVEY UNDER

Application No. 53099. Permit No. 38585.....  
IN NAME OF

**DONALD J. & PAULINE FETTIG**

Surveyed SEPT. 29. 1983., by *P. Paater*.....