


T. 34 S., R. 3 E., W. M.

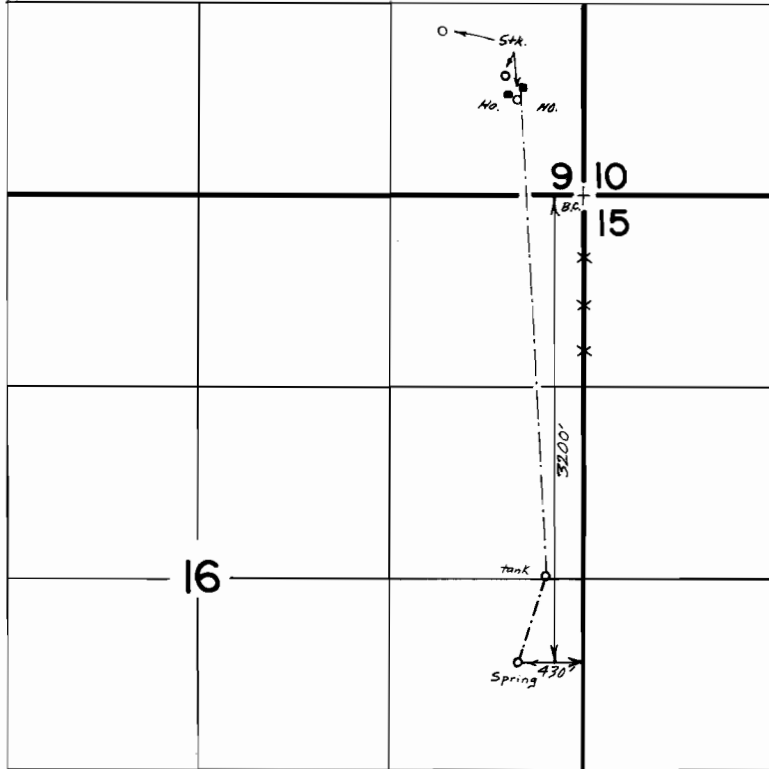

Scale 1" = 1320'

FINAL PROOF SURVEY

UNDER

Application No. 53134 Permit No. 38611
IN NAME OF

SARA E. WATTENBERGER

Surveyed May 1, 1986, by B.S.JAMES