


T. 5 S., R. 6 W., W.M.

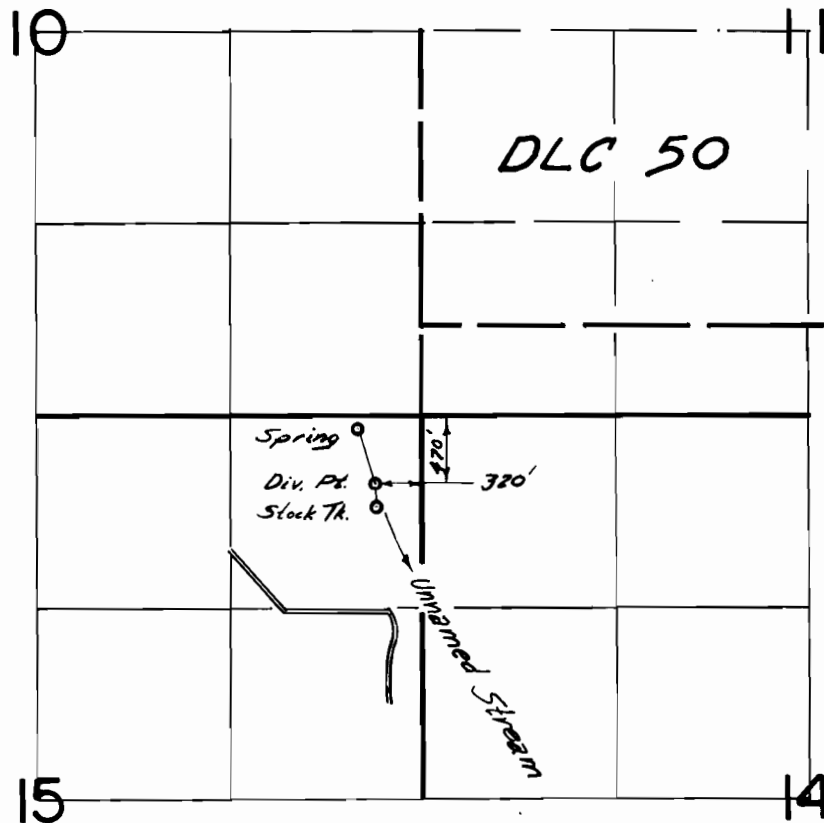

FINAL PROOF SURVEY
UNDER

Application No. 51118 Permit No. 38642
IN NAME OF

Lindsay Manufacturing Co.

Surveyed May 31, 1979 by dCBrown