


# T.5S., R.6W., W.M.

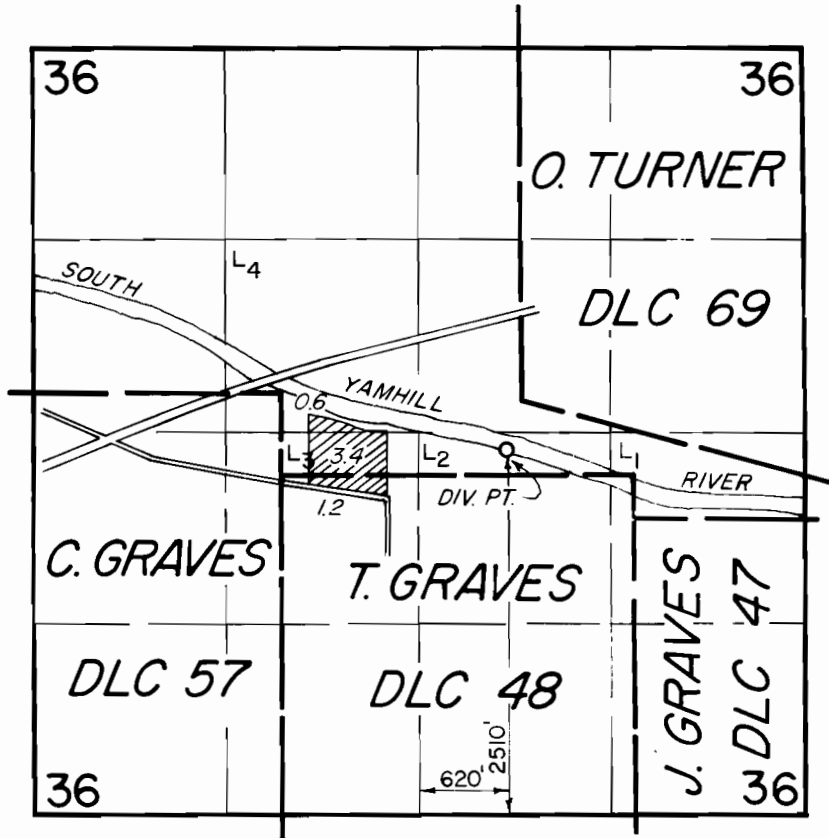

## FINAL PROOF SURVEY UNDER

Application No. 51170... Permit No. 38673.....

IN NAME OF

VIRGIL CORDIE

Surveyed JUNE 1, 1979, by *W. Brown*.....