


T.39 S., R.8W., W.M.

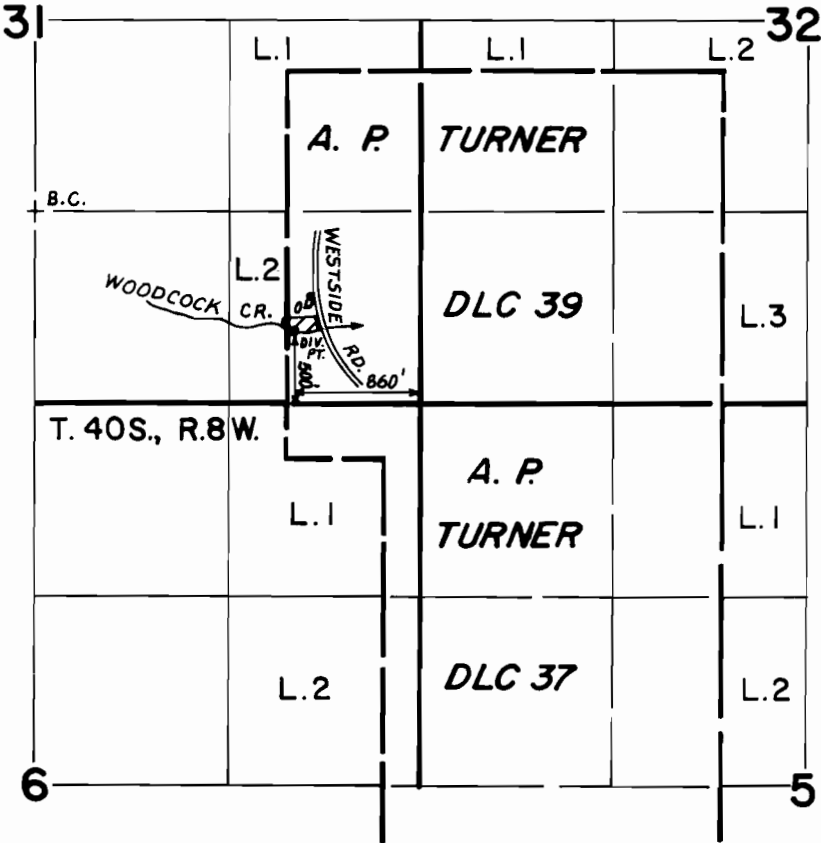

SCALE: 1"=1320'

FINAL PROOF SURVEY UNDER

Application No. **51185**..... Permit No. **38680**.....
IN NAME OF

.....**GLENN PROTTSMAN**.....

Surveyed **MAR. 29 1984**, by **B. S. JAMES**.....