


T.30S.,R.5W.,W.M.

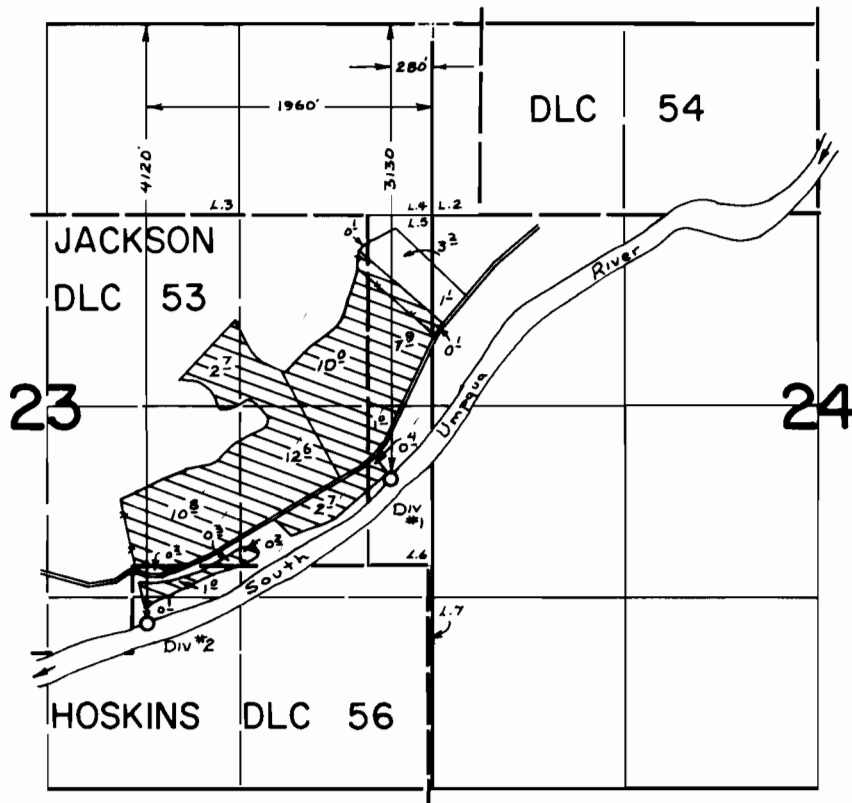

FINAL PROOF SURVEY

UNDER

Application No. 51234... Permit No. 38702.....

IN NAME OF

.....WEBSTER BRIGGS.....

Surveyed June 25, 1980, by J.S. DONALDSON