


T.18S.,R.3W.,W.M.

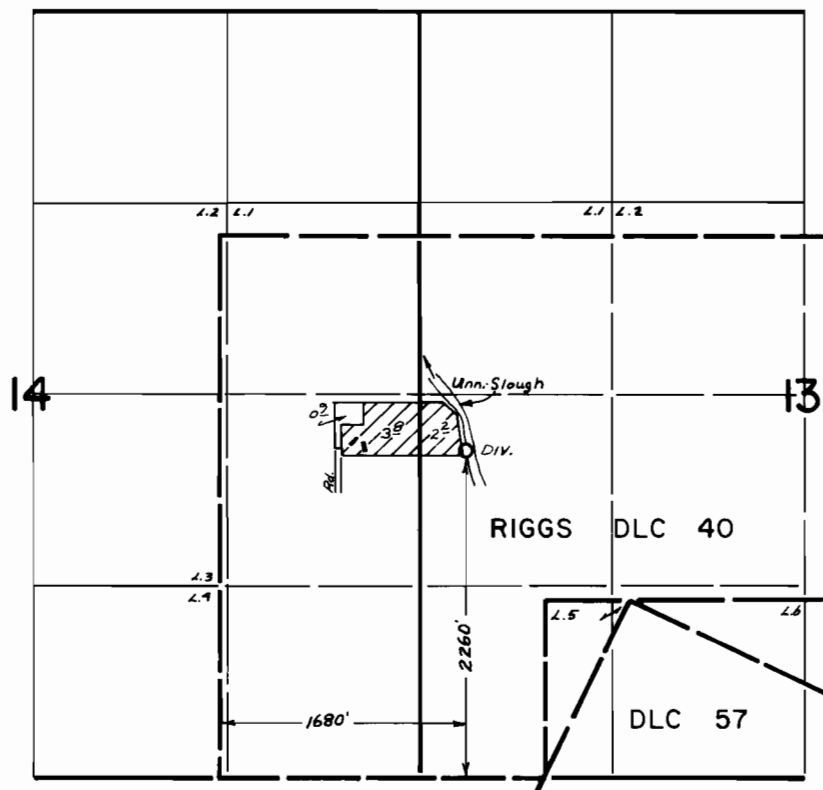

FINAL PROOF SURVEY UNDER

Application No. 52352.. Permit No. 39391.....
IN NAME OF

JACK H. & PAULINE KUHN.....

Surveyed May 8, 1980, by B. W. BISHOP.....
August 19, 1981 S. C. BROWN