


T. 5 S., R. 4 W. WM

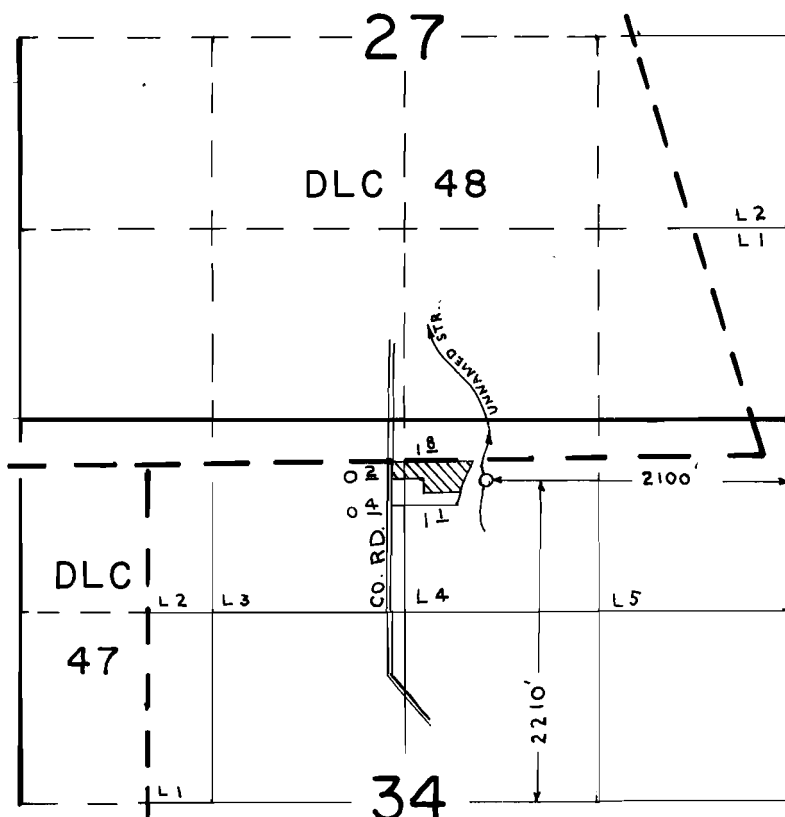

**FINAL PROOF SURVEY**  
UNDER

Application No. 53139 Permit No. 38773

IN NAME OF

DORIS RICHMOND

Surveyed APR 26, 1984, by P. PAGTER