


T.2S.,R.3W.,W.M.

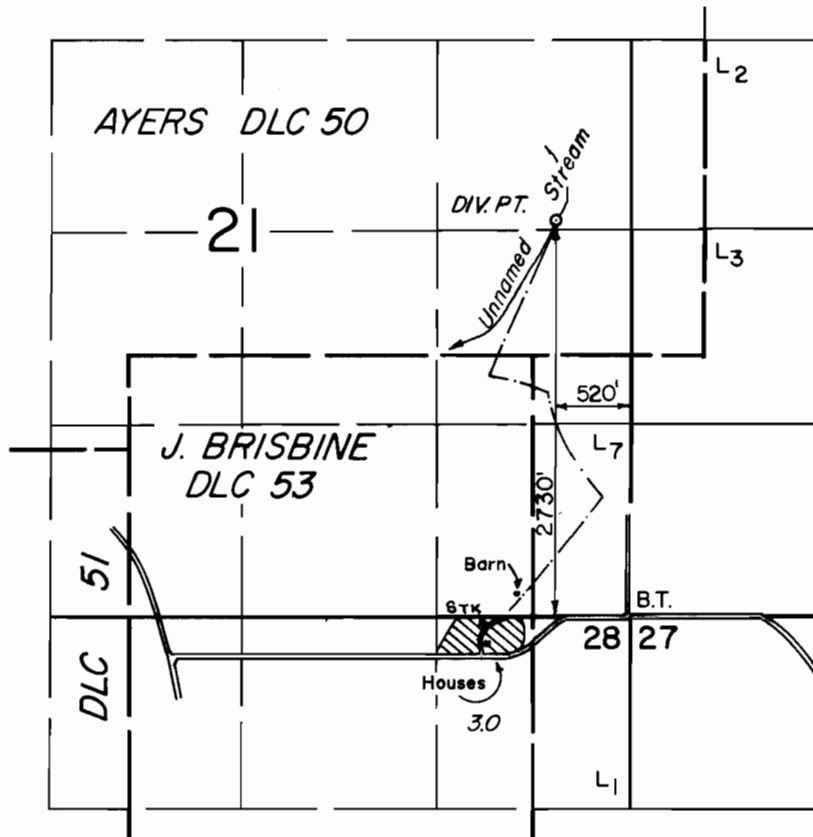

FINAL PROOF SURVEY UNDER

Application No. 53148 Permit No. 38779
IN NAME OF

Burton A. & Angeline E. Thompson

Surveyed JUNE 19, 1979, by Al Brown