


T. 1S., R. 10E., W.M.

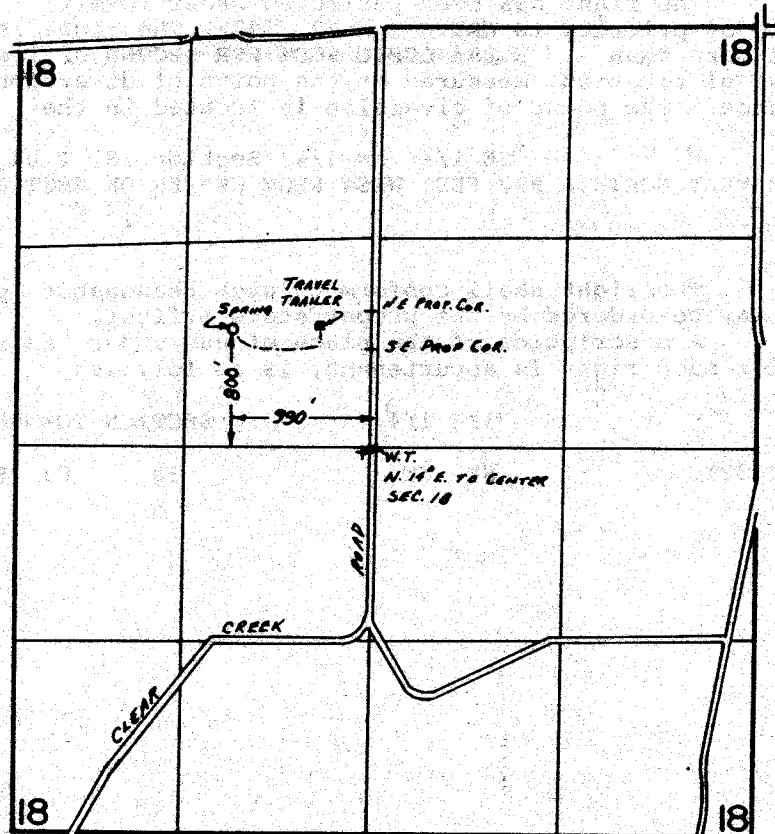

**FINAL PROOF SURVEY**  
UNDER

Application No. 53162 Permit No. 38788  
IN NAME OF

MRS. BERNHARD KARL FRANZ

Surveyed JUNE 10 1980, by R.G. MUCKEN