


T. 12S. R. 1E. W.M.

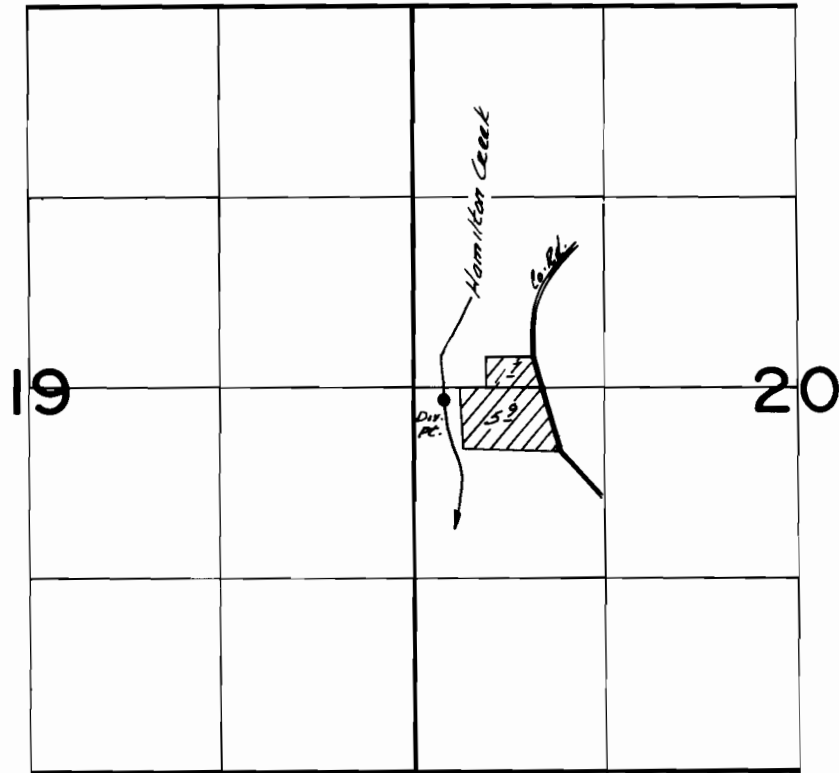

Div. Pt. Loc. - 80' S $\frac{1}{2}$ 220' E from W $\frac{1}{4}$ Cor. Sec. 20

FINAL PROOF SURVEY
UNDER

Application No. **51378**.. Permit No. **38849**.....
IN NAME OF

WILLIAM & NANCY EARLYWINE..

Surveyed **MAY...3...** 1979, by **S.C. BROWN**.....