


T.27S.,R.7W.,W.M.

Section 20

NW 1/4 SW 1/4

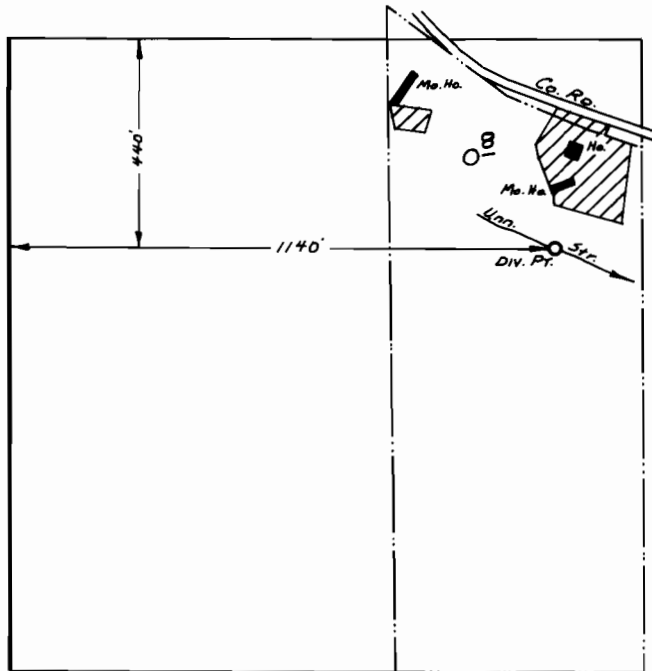

SCALE: 1" = 400'

**FINAL PROOF SURVEY**  
UNDER

Application No. 51669 Permit No. 38959

IN NAME OF

HAROLD E. & HAROLD D. CHURCH

Surveyed June 23, 1982, by L. M. TOLL