


T.1S., R.39E., W.M.

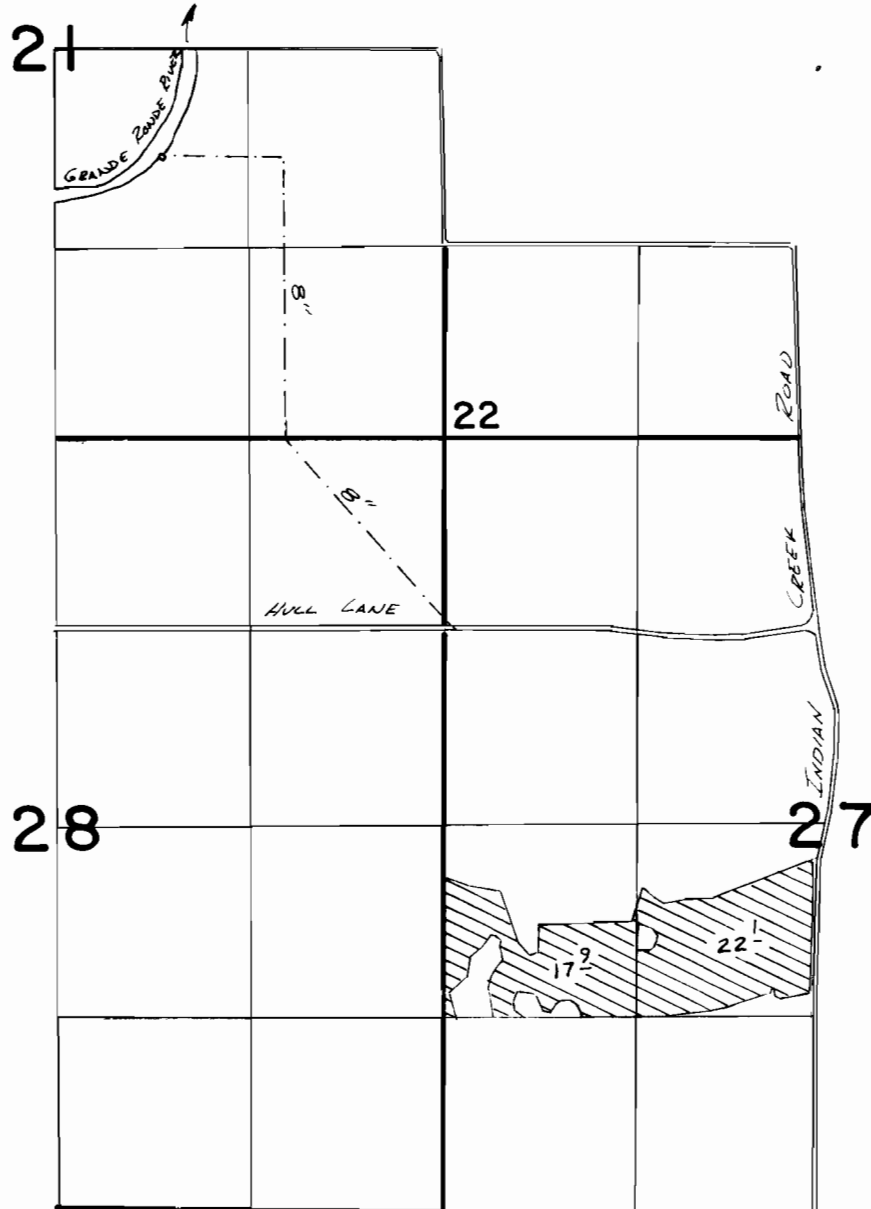

DIV. PT. - 725' S. & 690' E. FROM CENTER SECTION 21

FINAL PROOF SURVEY

UNDER

Application No. **51675**... Permit No. **38962**...
IN NAME OF

.....**J. L. WESTENSKOW**.....

Surveyed Nov. 18 1981, by V.R. Church