


T.11S., R.1W. & 1E., W.M.

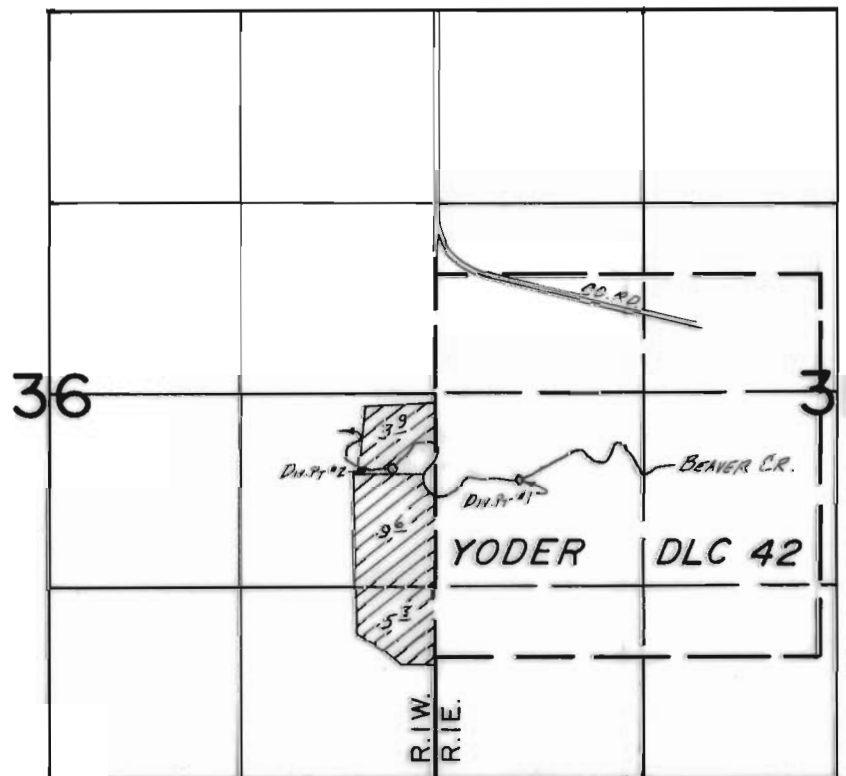

Dist. Pts. Loc: #1-600'S. & 580'E.; #2-500'S. & 500'W, BOTH FROM THE E. 1/4 COR. SEC. 36, T.11S., R.1W., W.M.

FINAL PROOF SURVEY
UNDER

Application No. 51739... Permit No. 38999...
IN NAME OF

FRED P. & SUSAN P. KLEINSCHMIT

Surveyed MAY 25, 1982, by L.M. TOLL