


T.5S.R.10W.W.M.

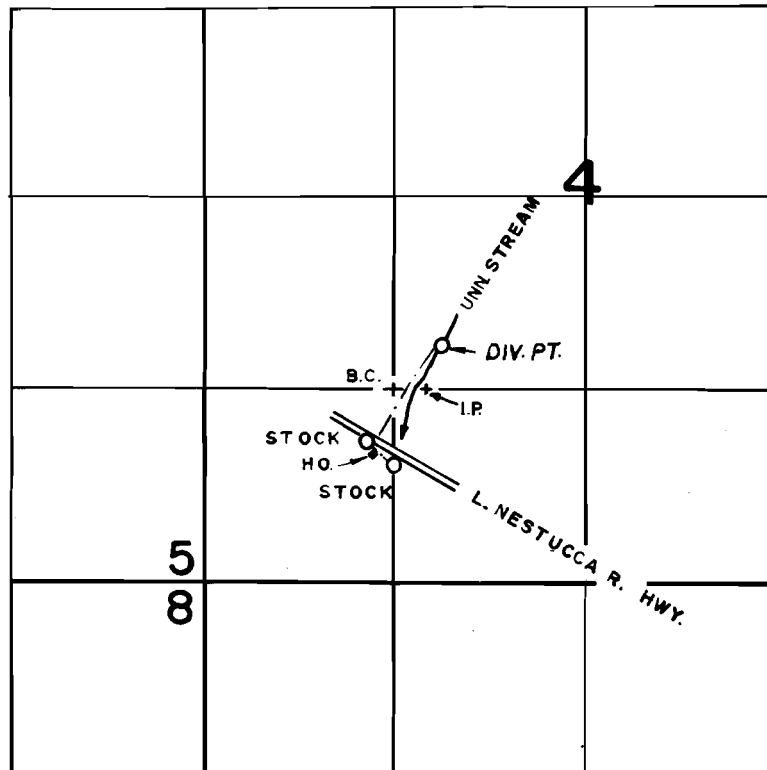

DIV. PT. LOC. 300' N. & 340' E. FROM NE. COR. S.W. 1/4 S.W. 1/4 SEC. 4

FINAL PROOF SURVEY
UNDER

Application No. 53,483 Permit No. 39186.....
IN NAME OF

ARCHIE K. MECKLEM

Surveyed JAN. 22, 1980, by R.G. MUCKEN.....