


T. 36 S., R. 2 W., W.M.

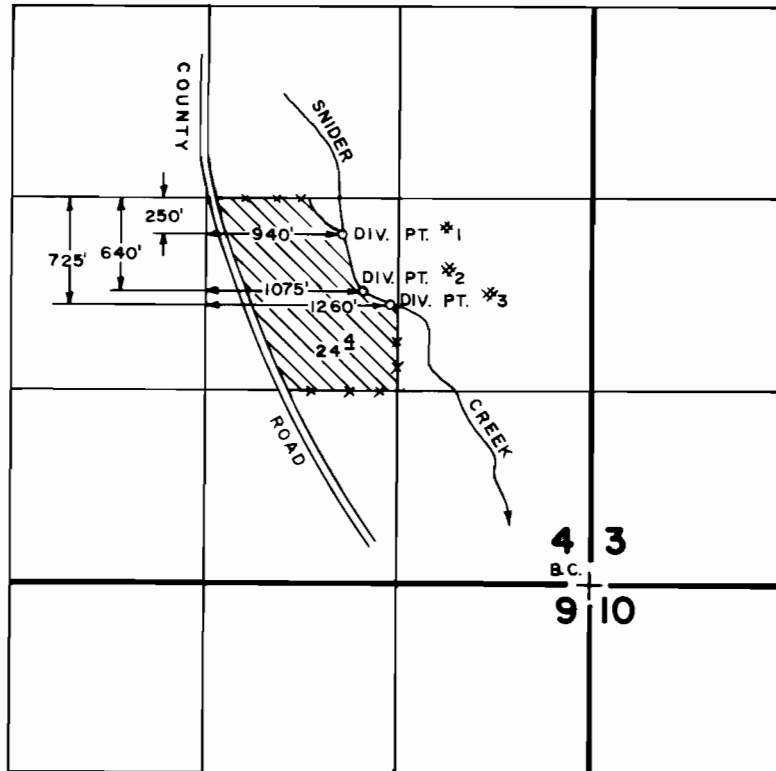

FINAL PROOF SURVEY
UNDER

Application No. **51994** Permit No. **39197**.....
IN NAME OF

HOMER V. &/or ANNE L. HAYNES

Surveyed **FEB. 4** 19**83**, by **B. SUZIE JAMES**

SCALE: **4" = 1 MILE**