


T. 3N., R. 2W., W.M.

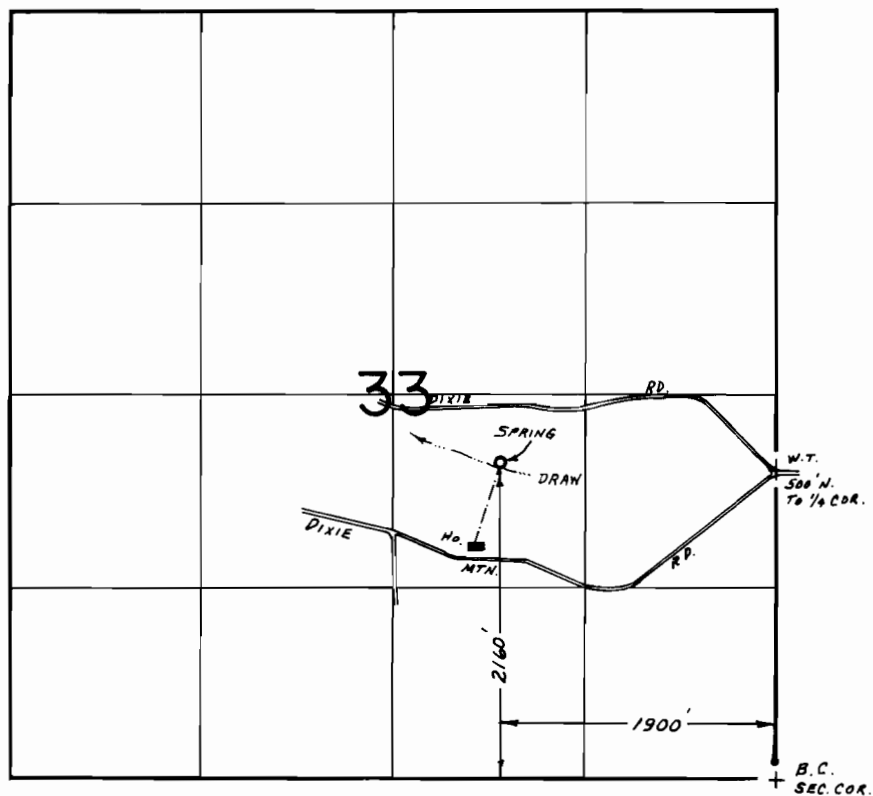

FINAL PROOF SURVEY
UNDER

Application No. 52053... Permit No. 39229.....
IN NAME OF

.....ESTATE OF RALPH M. MOFFITT.....

Surveyed JULY 24, 1980, by R.G. MUCKEN.....