


T.34 S., R. 5 W., W.M.

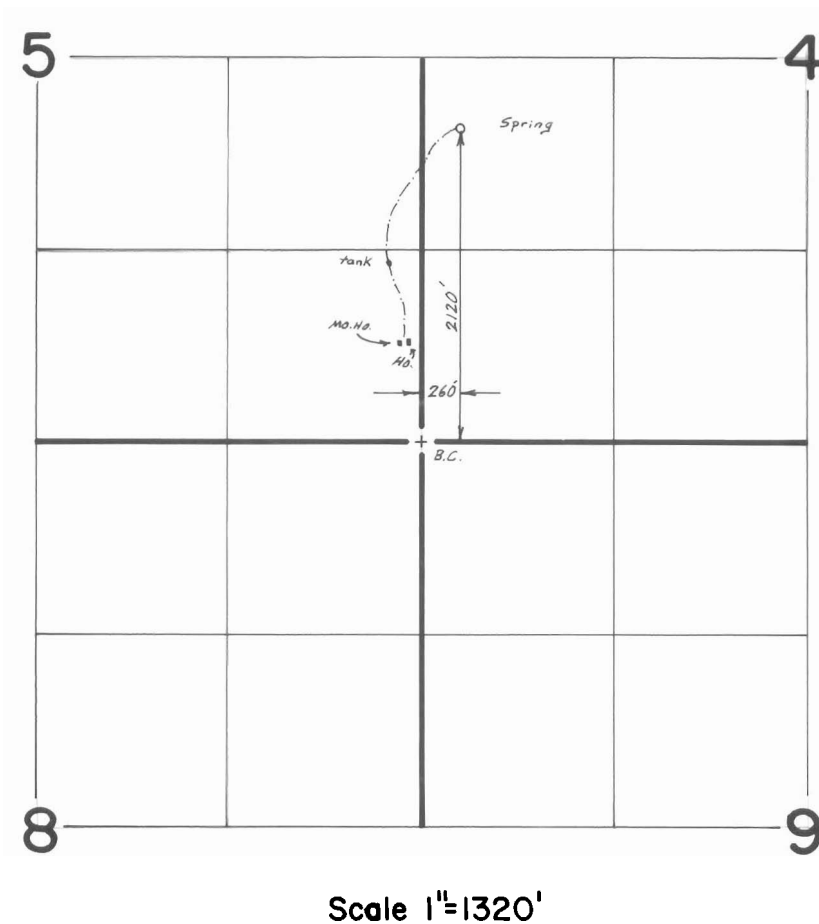

FINAL PROOF SURVEY

UNDER

Application No. 52133 Permit No. 39266
IN NAME OF

.....WILLIAM.....M.....LASITER.....

Surveyed Sept. 9, 1986, by B.S. JAMES.....