


T.33S., R.5W., W.M.

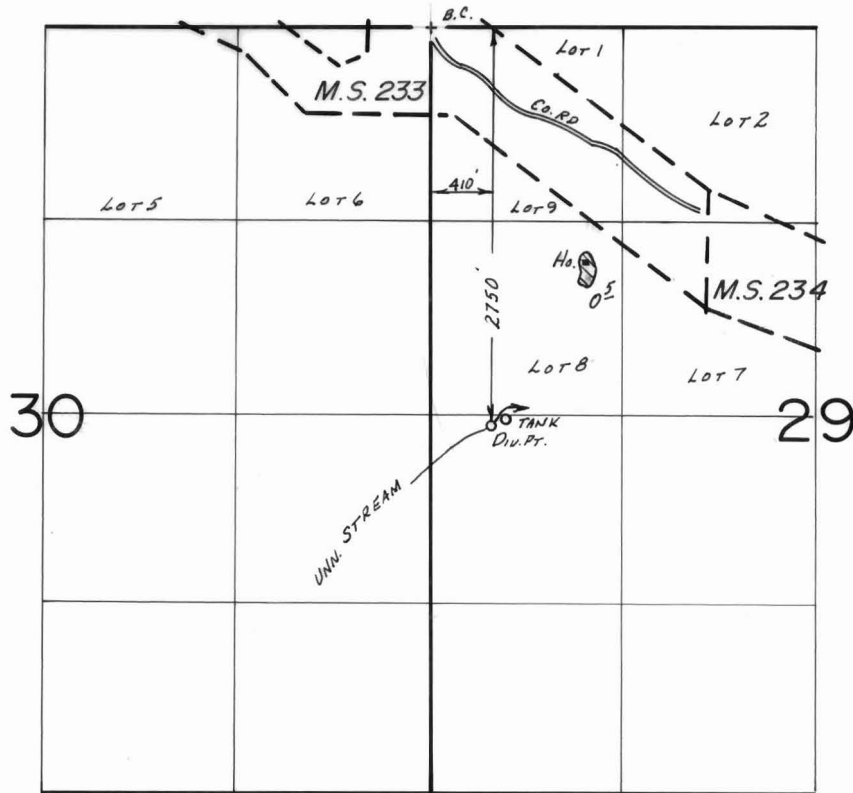

SCALE: 1" = 1320'

FINAL PROOF SURVEY UNDER

Application No. 52178 Permit No. 39289.....
IN NAME OF

.....VERNON KEPPLER.....

Surveyed Aug. 29, 1984, by J.R. WOODROOF.....