


T.35 S., R.1 W., W.M.
SEC. 29

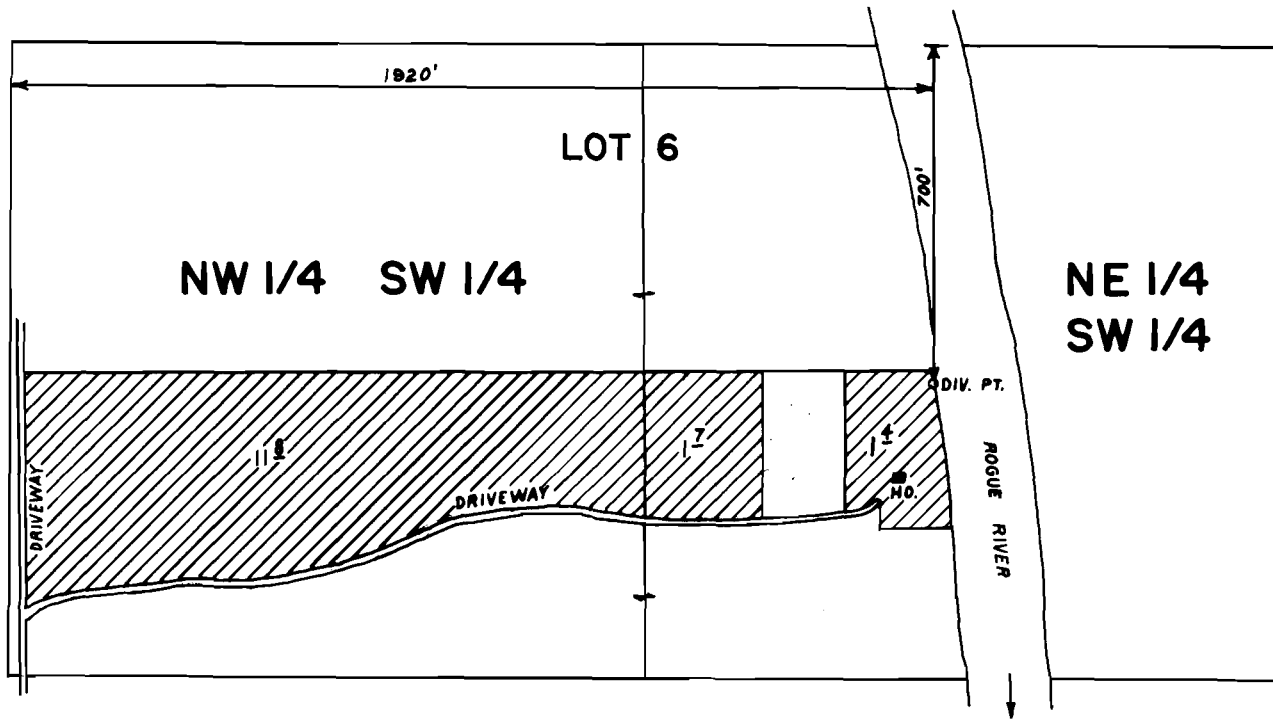

Scale: 1" = 400'

FINAL PROOF SURVEY
UNDER

Application No. 52199 Permit No. 39304
IN NAME OF

JOHN &/or ANNE BATZER

Surveyed JULY 12, 1983, by B. S. JAMES