


1N 12E 14

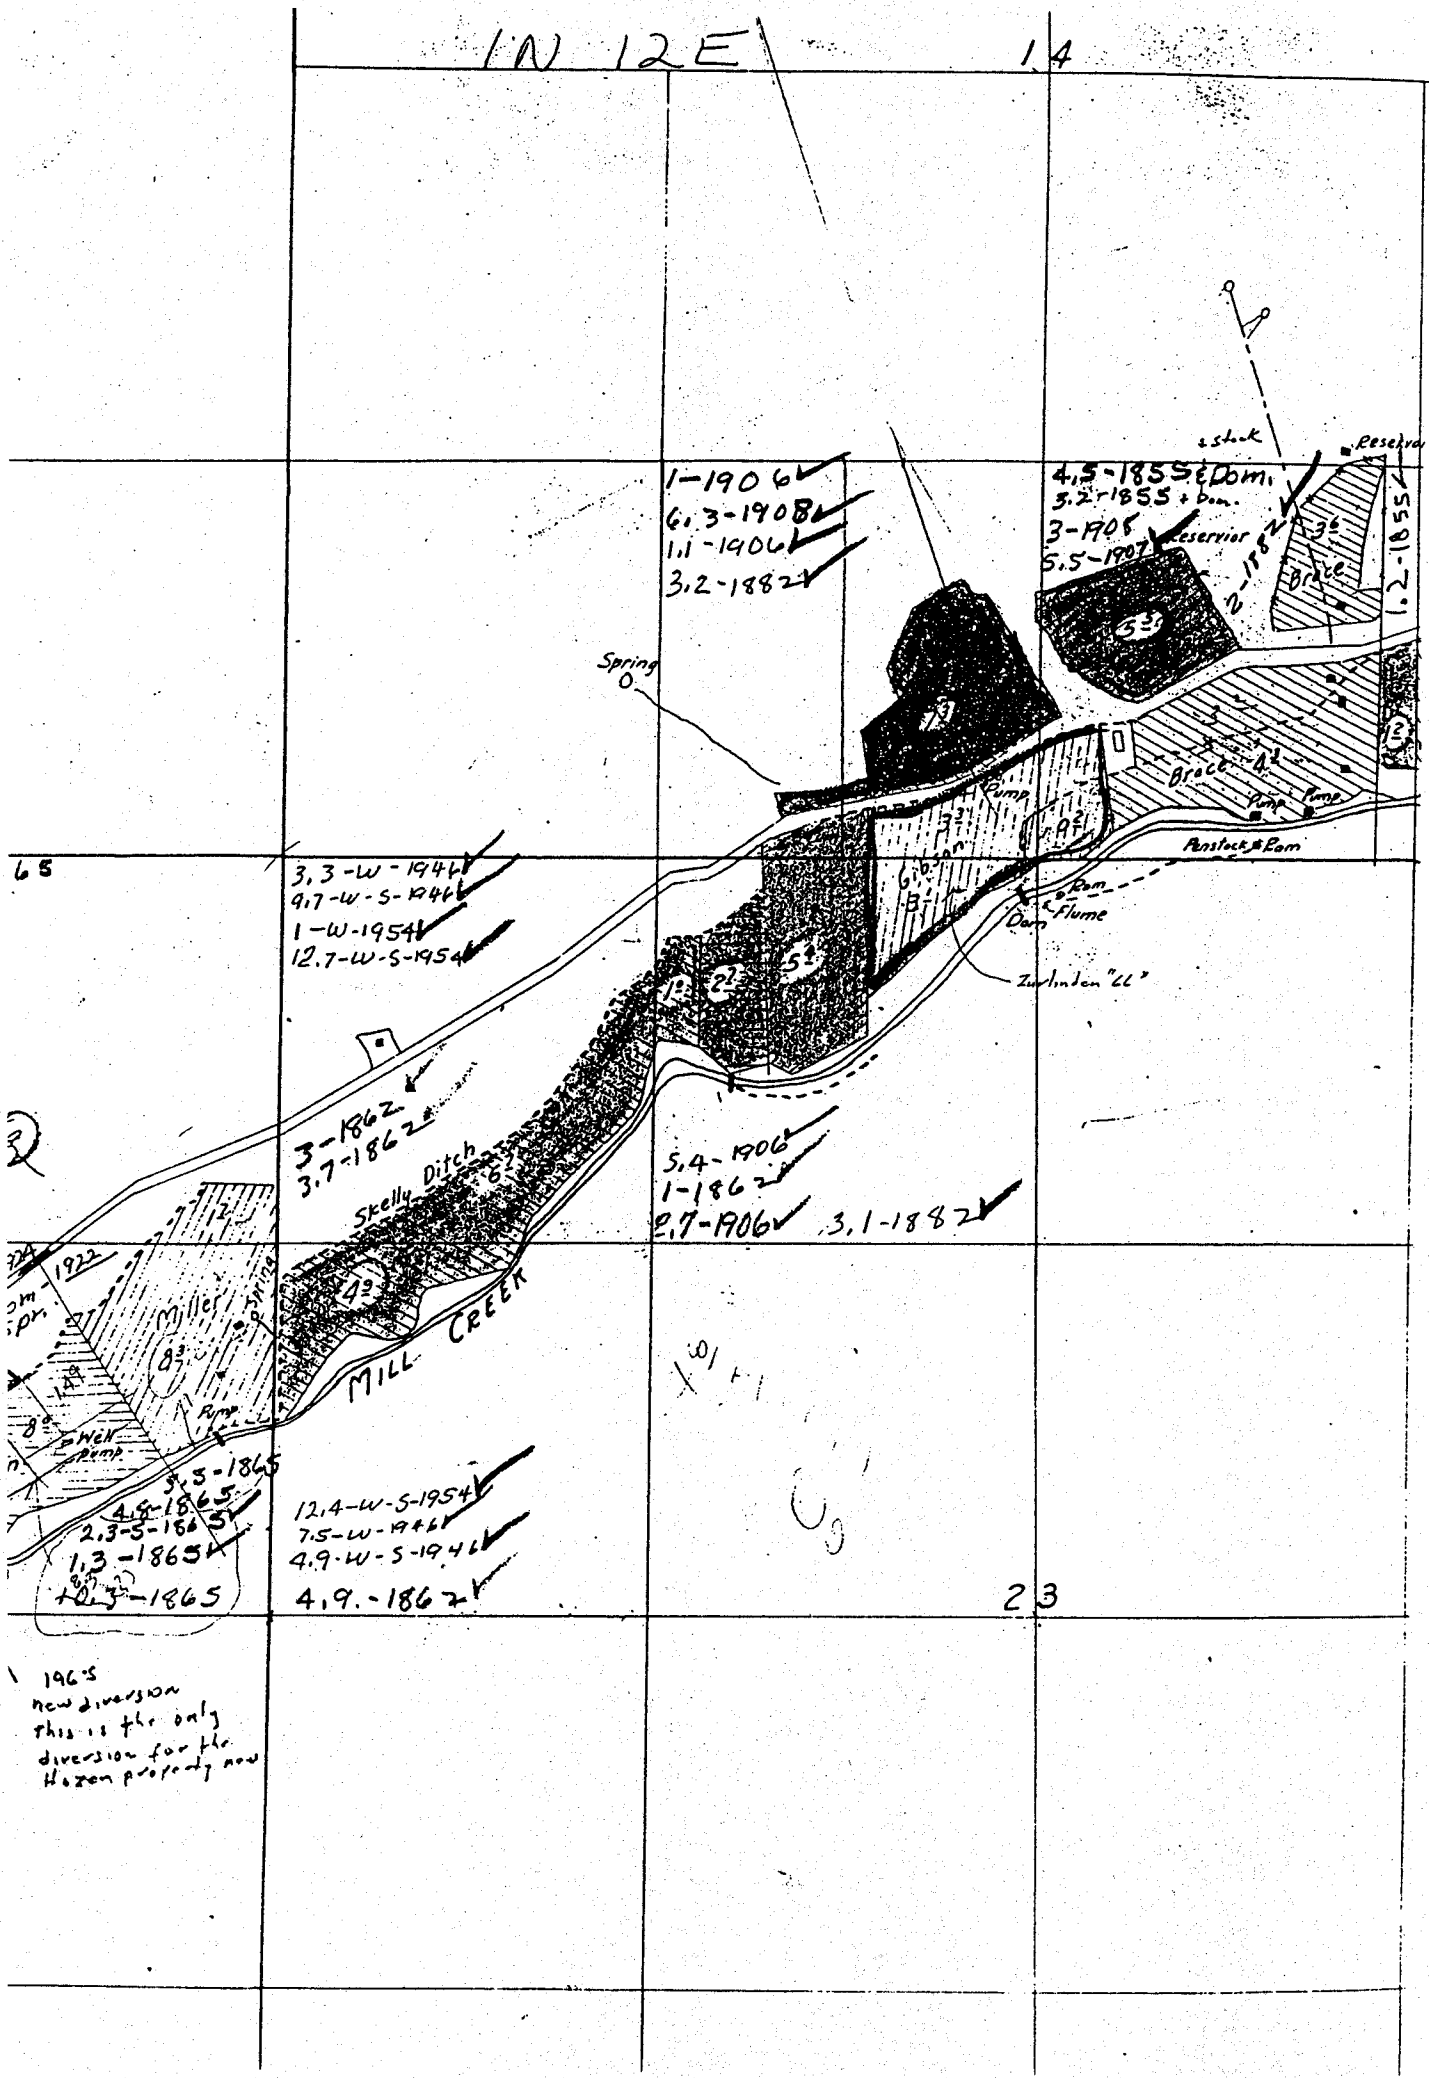

65

2

1922

83

83

101

09

23

1965
 new diversion
 this is the only
 diversion for the
 Hazen property now