


T.13 S., R.1 & 2 E., W.M.

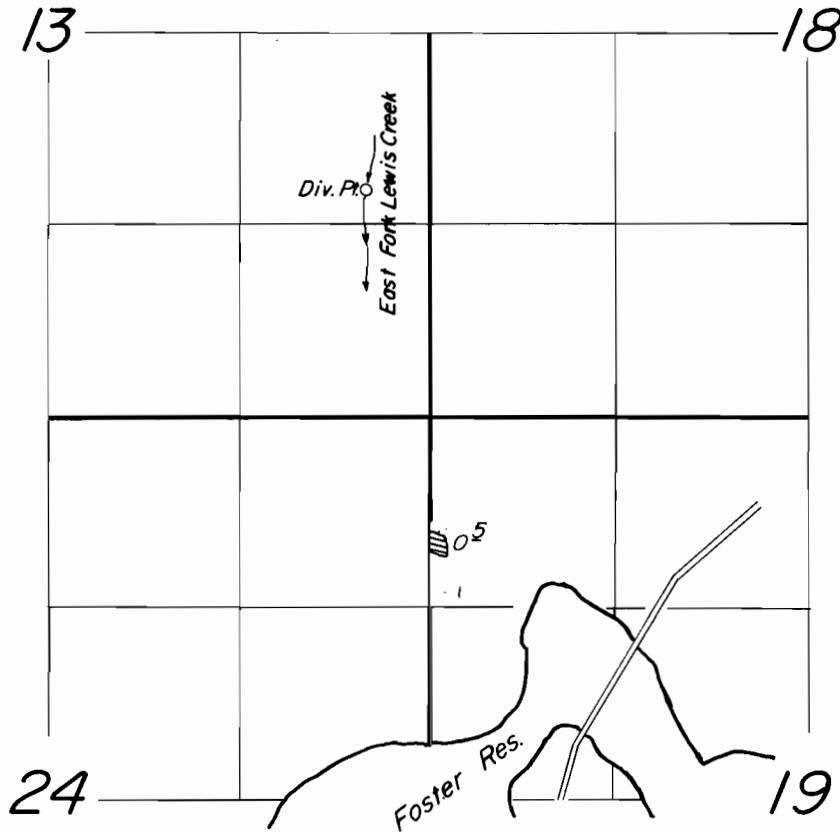

Diversion Point Loc.: 1560' N. & 430' W. from SE Cor. Sec. 13.

Scale: 1" = 1320'

FINAL PROOF SURVEY UNDER

Application No. 52357... Permit No. 39393.....
IN NAME OF

GEORGE T. & BESS N. EDWARDS

Surveyed JUNE 15, 1984, by L. TOLL.....