


T. 30 S., R. 3 W., W.M.

SCALE: 4" = 1 mile

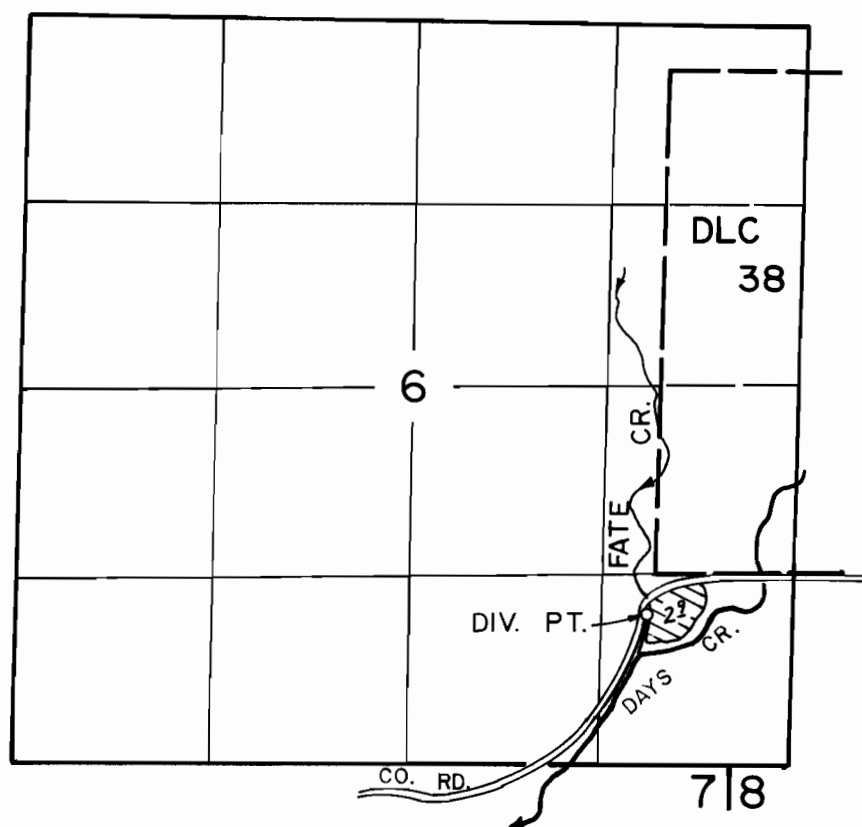

DIV. PT. LOCATED 270' S. and 50' W. of S.W. CORNER DLC 38.

FINAL PROOF SURVEY
UNDER

Application No. 53247 Permit No. 39514
IN NAME OF

DENNIS BURRIS

Surveyed AUG 24 19 83, by J.S. DONALDSON