


# T.9S. R.4W. W.M.

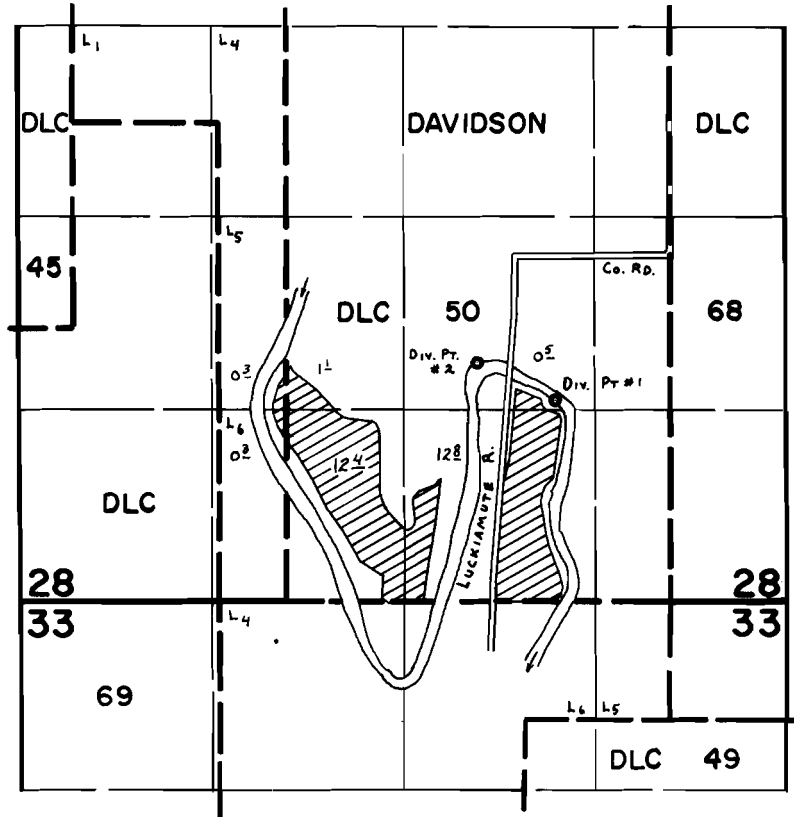

Div. Pts. Loc:  
 #1- 1380' N. & 780' W. } BOTH FROM S.E. COR. DAVIDSON D.L.C. 50.  
 #2- 1640' N. & 1340' W. }

## FINAL PROOF SURVEY UNDER

Application No. 53276.. Permit No. 39535.....  
 IN NAME OF

DESSERT SEED CO., INC.

Surveyed July 20, 1979, by C.L. HUGHES.....