


T. 39 S., R. 5 W., W. M.

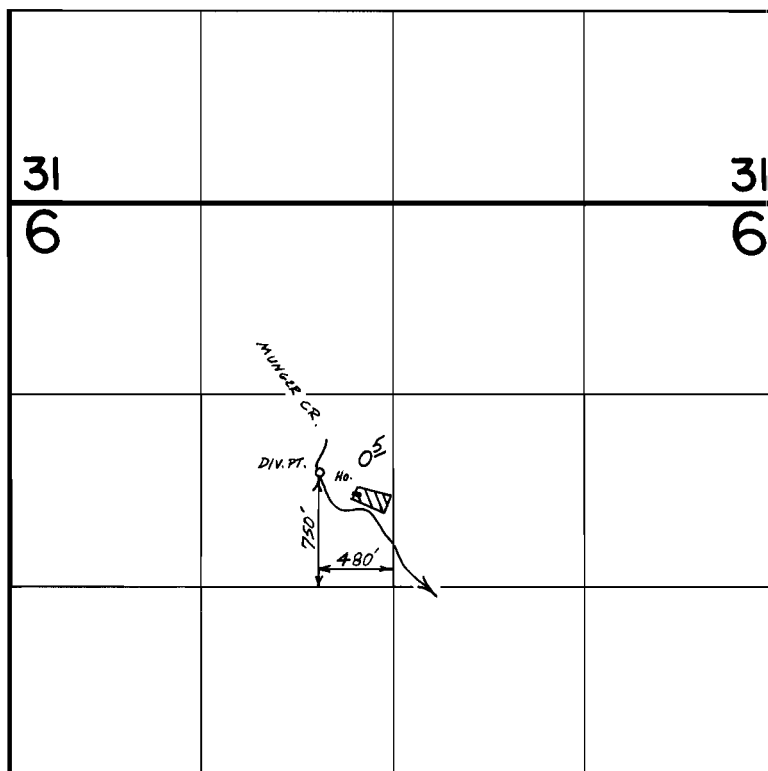

Scale 1" = 1320'

FINAL PROOF SURVEY
UNDER

Application No. ~~53288~~. Permit No. ~~39544~~.....
IN NAME OF

HUI ALOHA

Surveyed Aug. 15... 1984., by B.S. JAMES.....