


T.3S., R.3W., W.M.

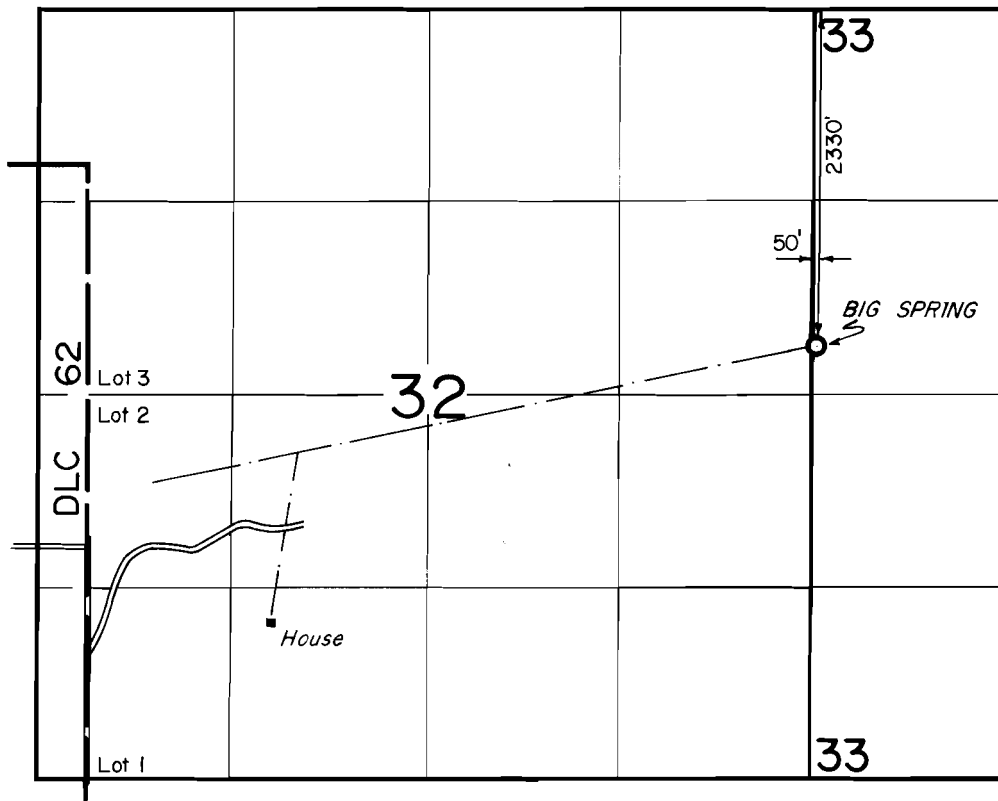

FINAL PROOF SURVEY
UNDER

Application No. 53303 Permit No. 39550
IN NAME OF

James M. Wood

Surveyed June 20, 1979, by *John B. ...*