


T. 3 S., R. 3 W. W.M.

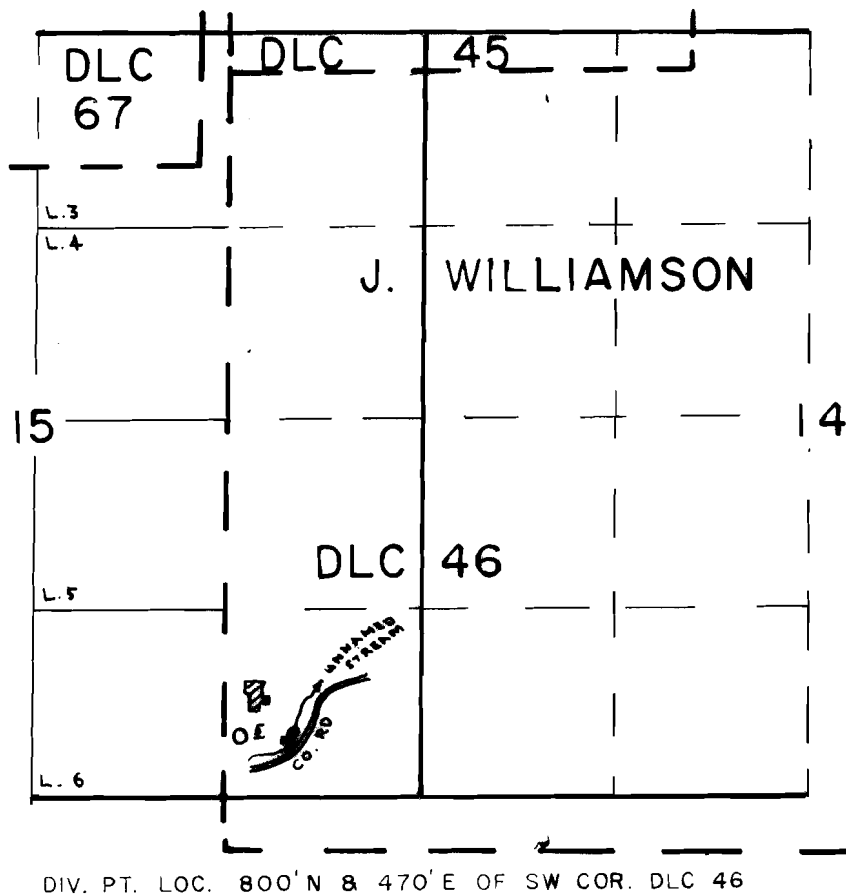

**FINAL PROOF SURVEY**  
UNDER

Application No. 53308 Permit No. 39554  
IN NAME OF

DURELL & DELPHA BELANGER

Surveyed JUL 2 1984, by P. PAGTER